

Ohio Building Code requires that buildings be accessible per 2017 ICC A117.1. The following is not intended to be a full description of the accessibility requirements, but a selection of the more commonly referenced sections. Contractors shall familiarize themselves with these requirements. Full text of this code can be found at <https://bit.ly/A117-2017>

ANSI Chapter 3 - Building Blocks

For full text of this chapter, see <https://bit.ly/A117-3>

Section 302 Floor Surfaces. Refer to full document for additional information.

302.1 General. Floor surfaces shall be stable, firm, and slip resistant, and shall comply with Section 302. Changes in level in floor surfaces shall comply with Section 303.

302.2 Carpet. See full A117.1 text for Carpet requirements. See Figure 302.2.

302.3 Openings. See full A117.1 text for opening limitations. See figure 302.3

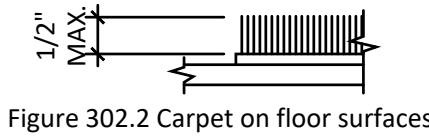


Figure 302.2 Carpet on floor surfaces

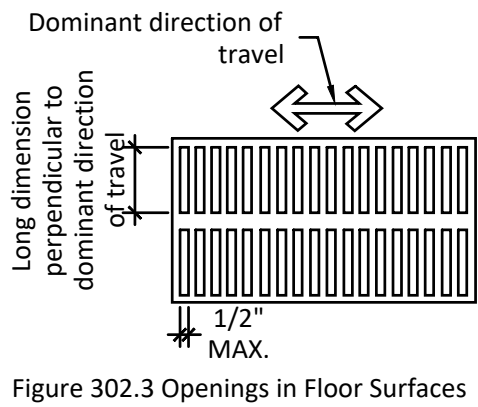


Figure 302.3 Openings in Floor Surfaces

Section 303 Changes in Level. Refer to full document

Changes in Level shall comply with the following Figures.

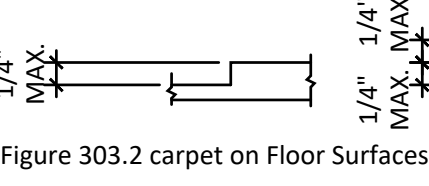


Figure 303.2 carpet on Floor Surfaces

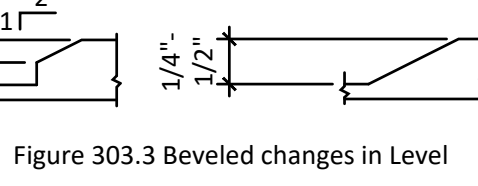


Figure 303.3 Beveled changes in Level

Section 304 Turning Space. Refer to full document

Turning Spaces shall comply with the following Figures

304.3.1 Circular Turning Spaces.

Where circular turning spaces are indicated, they shall comply with the following Figures.

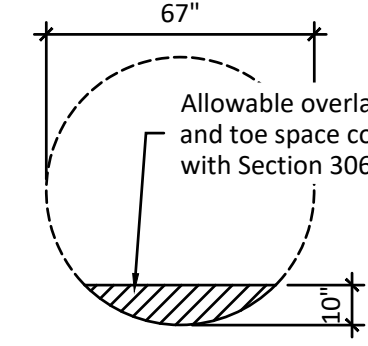


Figure 304.3.1.1 Circular Turning Space - New Buildings

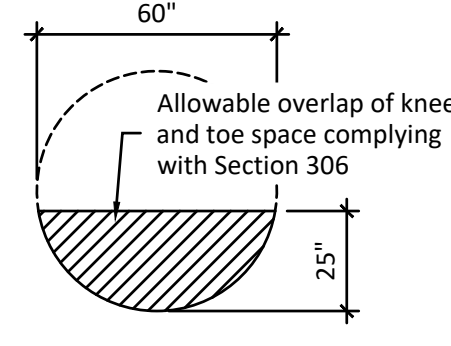


Figure 304.3.1.1 Circular Turning Space - Existing Buildings

304.3.2.1 T-Shaped Turning Spaces - New Buildings.

Where T-shaped turning spaces are indicated, they shall comply with 304.3.2.1 or 304.3.2.2 below

304.3.2.1.1 Turning spaces shall be permitted to include knee and toe space complying with Section 306 in either the base or one arm of the turning space (shown shaded below)

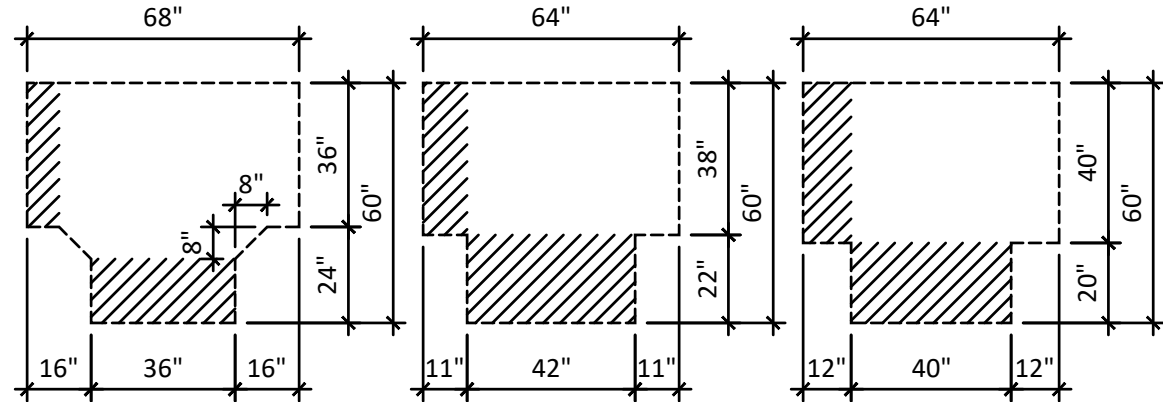


Figure 304.3.2.1(A) Option 1

Figure 304.3.2.1(B) Option 2

Figure 304.3.2.1(C) Option 3

304.3.2.2 T-Shaped Turning Spaces - Existing Buildings

304.3.2.2.1 Turning spaces shall be permitted to include knee and toe space complying with Section 306 in either the base or one arm of the turning space (shown shaded below).

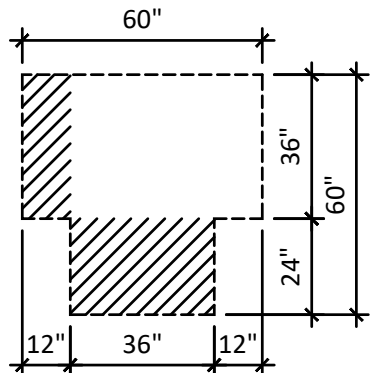


Figure 304.3.2.2 T-Shaped Turning Space - Existing Building

Section 305 Clear Floor Space. Refer to full document

Turning Spaces shall be provided and shall be the size indicated below.

305.3 Size

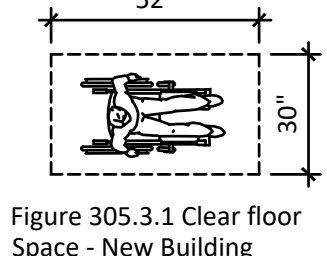


Figure 305.3.1 Clear floor Space - New Building

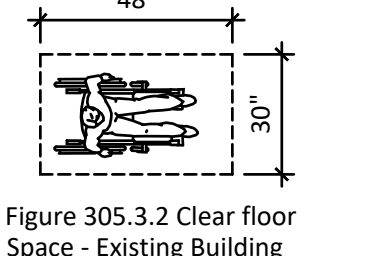


Figure 305.3.2 Clear floor Space - Existing Building

305.7 Alcoves.

Where the Clear floor space occurs in an alcove, additional clearance is required as indicated in the Figures below. 60"

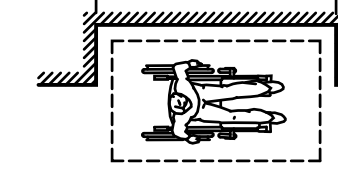


Figure 305.7.1 Maneuvering Clearance in an Alcove (Parallel Approach)

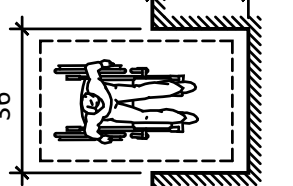


Figure 305.7.2 Maneuvering Clearance in an Alcove (Forward Approach)

Section 306 Knee and Toe Clearance. Refer to full document

Where space beneath an element is included as part of the clear floor space at an element, clearance at an element, or a turning space, the space shall comply with the images below.

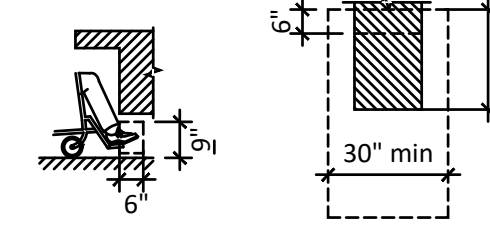


Figure 306.2(A) Toe Clearance Elev.

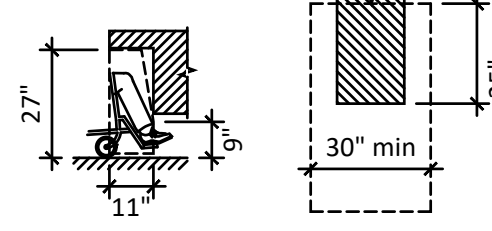


Figure 306.2(B) Toe Clearance Plan

Section 307 Protruding Objects. Refer to full document

Protruding Objects on a Circulation Path shall comply with the following Figures below

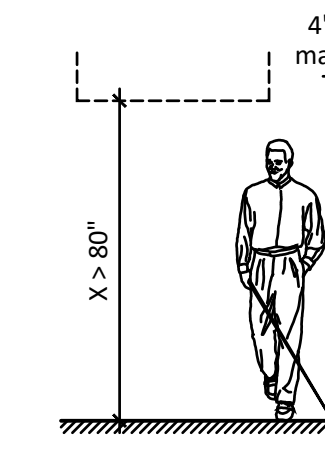


Figure 307.2 Limit of Protruding Objects

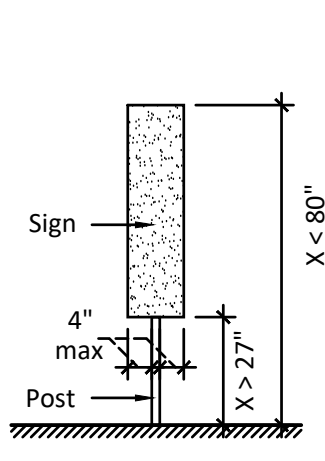


Figure 307.3(A) Post Mounted Protruding Objects

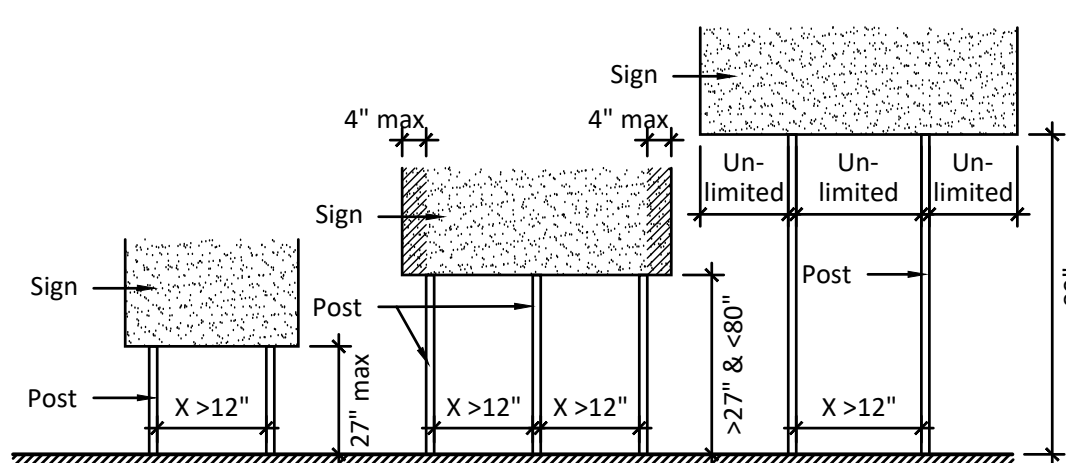


Figure 307.3(B) Post Mounted Protruding Objects

307.4 Vertical Clearance Vertical clearance shall be 80 inches min. Rails or other barriers shall be provided where the vertical clearance is less. The leading edge of such rails or barrier shall be located 27 inches max above the floor.

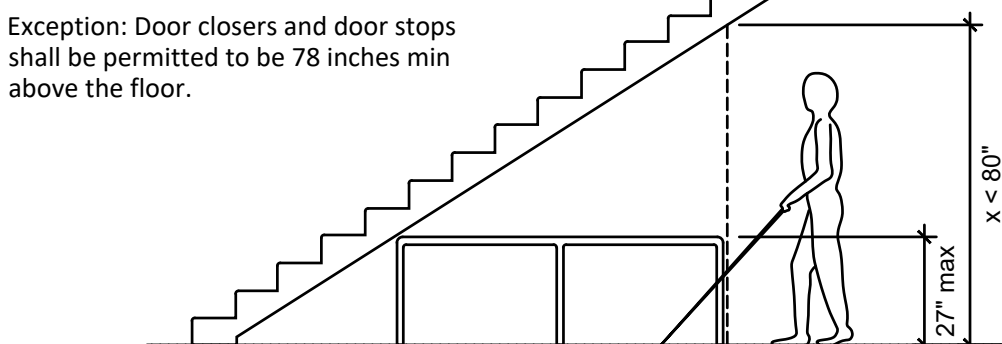


Figure 307.4 Reduced Vertical Clearance

Section 308 Reach Ranges. Refer to full document

Reach Ranges shall comply with the following Figures.

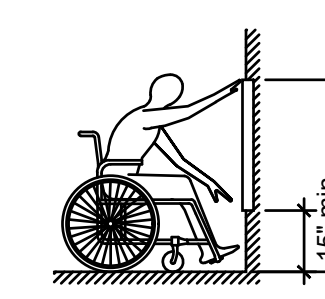


Figure 308.2.1 Unobstructed Forward Reach

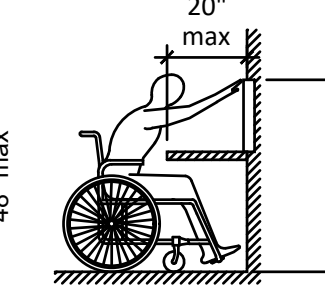


Figure 308.2.2(A) Obstructed High Forward Reach

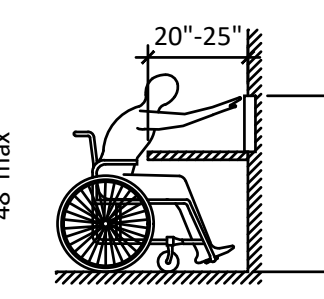


Figure 308.2.2(B) Obstructed High Forward Reach

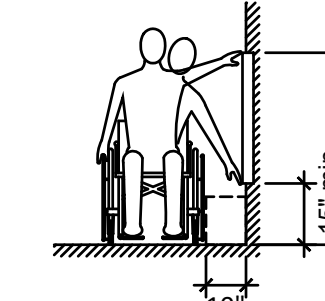


Figure 308.3.2.1 Unobstructed Side Reach

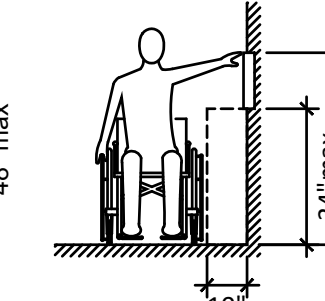


Figure 308.3.2.2(A) Obstructed High Side Reach

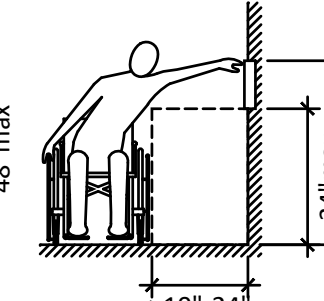


Figure 308.3.2.2(B) Obstructed High Side Reach

ANSI Chapter 4 - Accessible Routes

For full text of this chapter, see <https://bit.ly/A117-4>

Section 402 Accessible Routes. Refer to full document for additional information.

402.2 Accessible routes shall consist of one or more of the following components: walking surfaces with a running slope not steeper than 1:20, doors and doorways, gates, ramps, curb ramps excluding the flared sides, blended transitions, elevators and platform lifts. All components of an accessible route shall comply with the applicable portions of A117.1.

402.3 Revolving doors, revolving gates and turnstiles shall not be part of an accessible route.

Section 403 Walking Surfaces. Refer to full document

403.3 Slope. The running slope of walking surfaces shall not be steeper than 1:20. The cross slope shall not be steeper than 1:48.

403.5.1 The clear width of an interior accessible route shall be 36 inches min. The clear width of an exterior accessible route shall be 48 inches min except as indicated in the figures below.

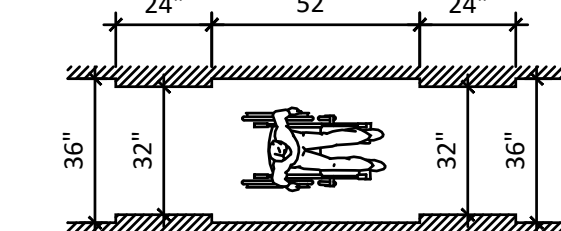


Figure 403.5.1(A) Clear Width of an Accessible Route - New Buildings - Interior

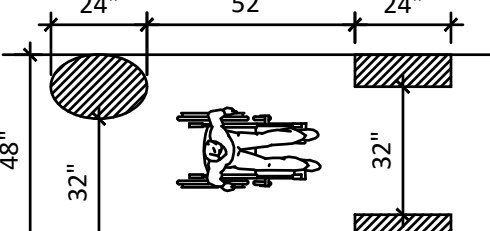


Figure 403.5.1(B) Clear Width of an Accessible Route - New Buildings - Exterior

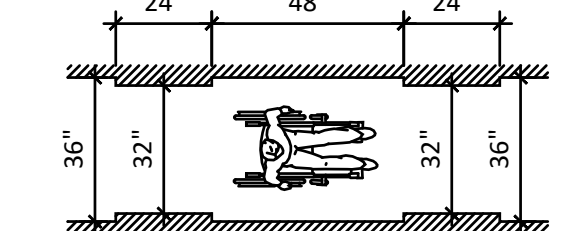


Figure 403.5.1(A) Clear Width of an Accessible Route - New Buildings - Interior

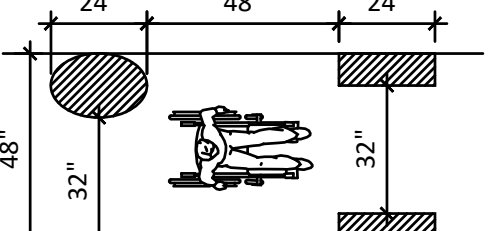


Figure 403.5.1(B) Clear Width of an Accessible Route - New Buildings - Exterior

403.5.2.1 Clear Width at 180-degree Turn - New Buildings. Where an accessible route makes a 180-degree turn around an object that is less than 52 inches in width, the clear widths approaching the turn, during the turn and leaving the turn, shall comply with one of the following images.

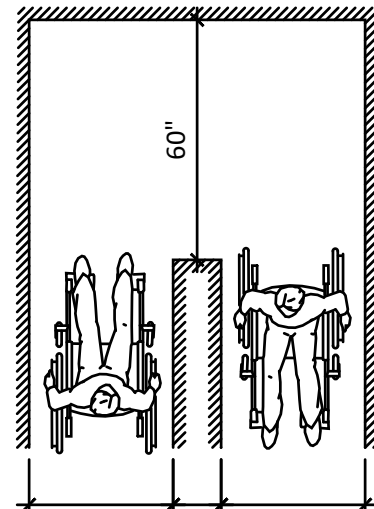


Figure 403.5.2.1(A) Clear Width at 180-Degree Turn - New Buildings - Option 1

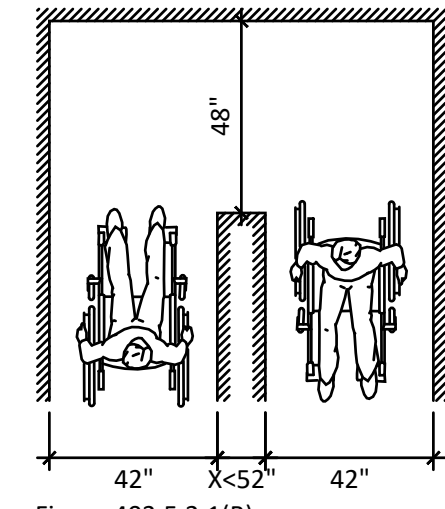


Figure 403.5.2.1(B) Clear Width at 180-Degree Turn - New Buildings - Option 2

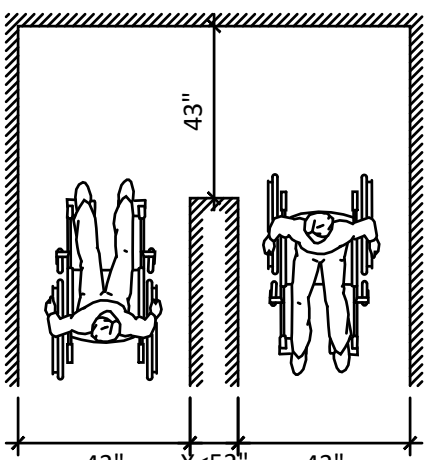


Figure 403.5.2.1(C) Clear Width at 180-Degree Turn - New Buildings - Option 3

403.5.2.2 Clear Width at 180-degree Turn - Existing Buildings and Facilities

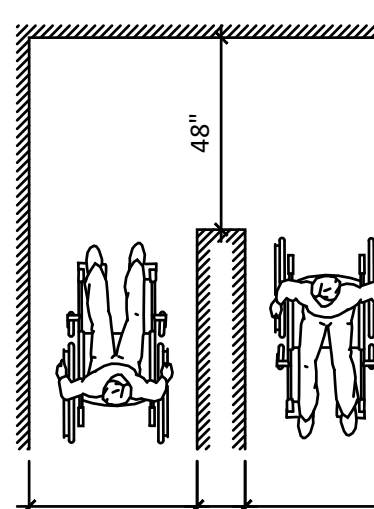


Figure 403.5.2.2(A) Clear Width at 180-Degree Turn - Existing Buildings

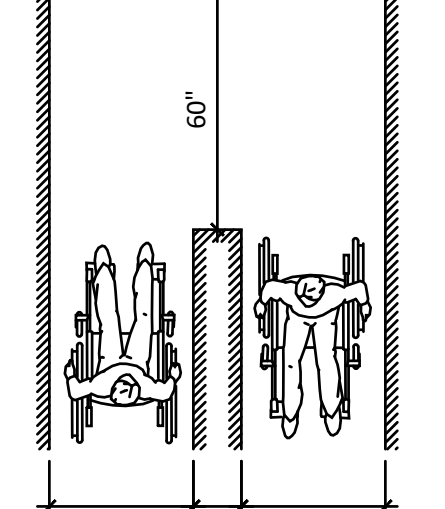


Figure 403.5.2.2(B) Clear Width at 180-Degree Turn - Existing Buildings - Exception

403.5.3.1 Clear Width at 90-degree Turn - New Buildings and Facilities. In new buildings, where an accessible route makes a 90-degree turn, the clear widths approaching and leaving the turn shall meet the dimensions indicated in the figures below.

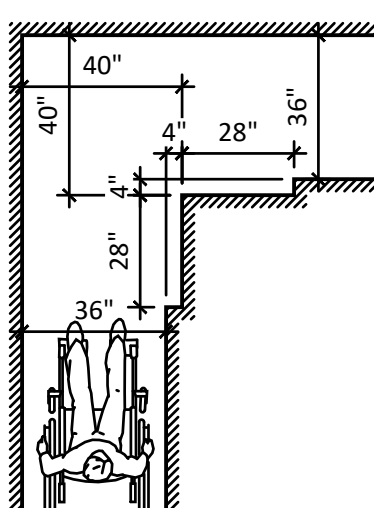


Figure 403.5.3.1(A) Clear Width at 90-Degree Turn - New Buildings - Option 1

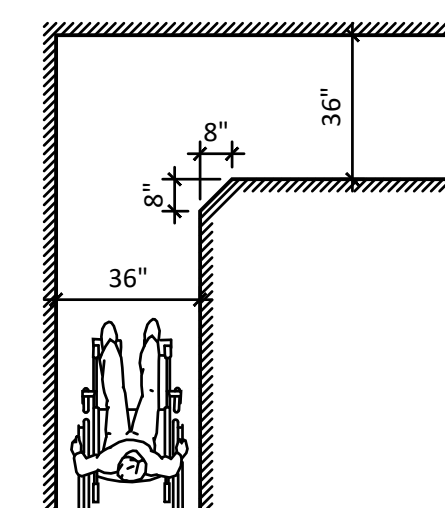


Figure 403.5.3.1(B) Clear Width at 90-Degree Turn - New Buildings - Option 2

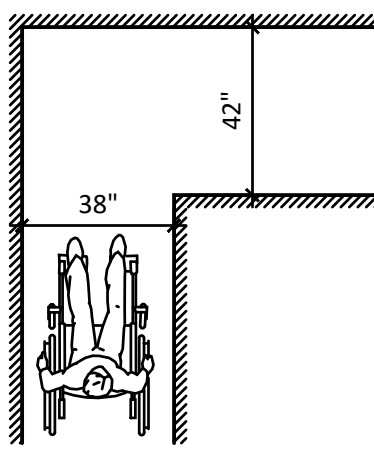


Figure 403.5.3.1(C) Clear Width at 90-Degree Turn - New Buildings - Option 3

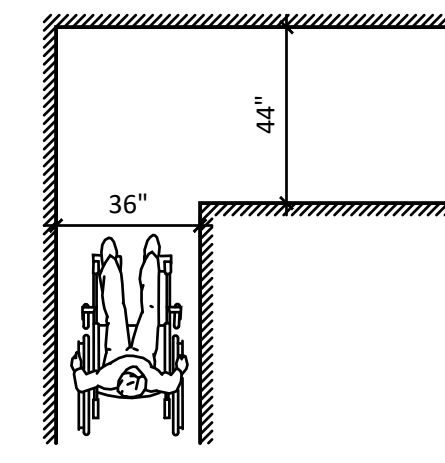


Figure 403.5.3.1(D) Clear Width at 90-Degree Turn - New Buildings - Option 4

403.5.3.2 Clear Width at 90-degree Turn - Existing Buildings and Facilities. In existing buildings, where an accessible route makes a 90-degree turn, the clear widths approaching and leaving the turn shall meet the dimensions indicated in the figure below.

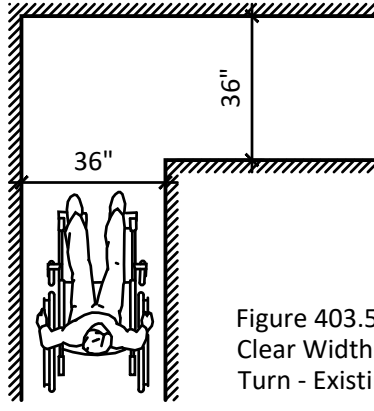


Figure 403.5.3.2 Clear Width at 90-Degree Turn - Existing Buildings

403.5.4 Passing Space. An accessible route with a clear width less than 60 inches shall provide passing spaces at intervals of 200 feet maximum. Passing spaces shall be either a 60-inch minimum by 60-inch minimum space, or an intersection of two walking surfaces that provide a T-shaped turning space.

403.5.4.1 New buildings and facilities. In new buildings and facilities, Passing spaces shall comply with the Figures below.

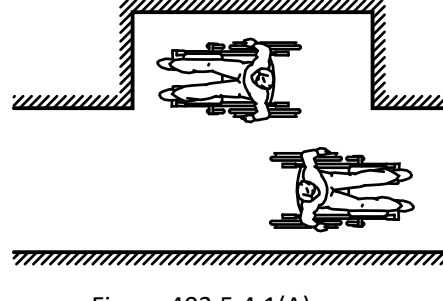


Figure 403.5.4.1(A) Passing Space - New Buildings - 60x60 Option

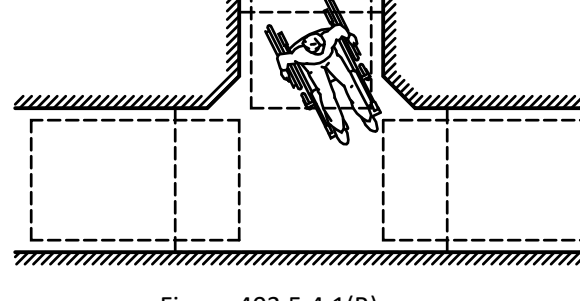


Figure 403.5.4.1(B) Passing Space - New Buildings - T-turn Option

403.5.4.2 Existing buildings and facilities. In existing buildings and facilities, Passing spaces shall comply with the Figures below.

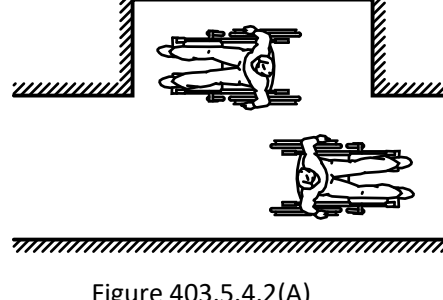


Figure 403.5.4.2(A) Passing Space - Existing Buildings - 60x60 Option

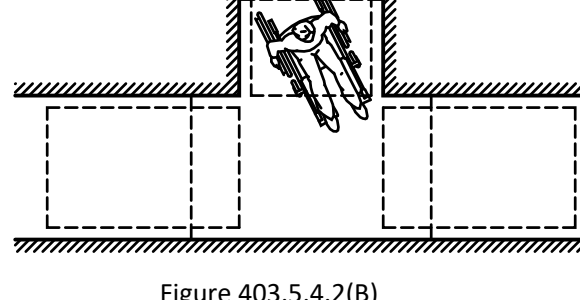


Figure 403.5.4.2(B) Passing Space - Existing Buildings - T-turn Option


Section 404 Doors, Doorways, and Gates. Refer to full document

404.1 General. Doors, doorways and gates that are part of an accessible route shall comply with Section 404 except Doors, doorways and gates designed to be operated only by security personnel shall not be required to comply with Sections 404.2.3, 404.2.6, 404.2.7, 404.2.8, 404.3.1, 404.3.2, 404.3.4, 404.3.7 and 404.3.8.

404.2 Manual doors, doorways and manual gates. Manual doors, doorways and manual gates intended for user passage shall comply with Section 404.2.

404.2.1 Double-leaf doors and gates. At least one of the active leaves of doorways with two leaves shall comply with Sections 404.2.2 and 404.2.3.

404.2.2 Clear width. Doorways shall have a clear opening width of 32 inches (815 mm) minimum. Clear opening width of doorways with swinging doors shall be measured between the face of door and stop, with the door open 90 degrees. Openings more than 24 inches (610 mm) in depth at doors and doorways without doors shall provide a clear opening width of 36 inches (915 mm) minimum. There shall be no projections into the clear opening width lower than 34 inches (865 mm) above the floor. Projections into the clear opening width between 34 inches (865 mm) and 80 inches (2030 mm) above the floor shall not exceed 4 inches (100 mm).


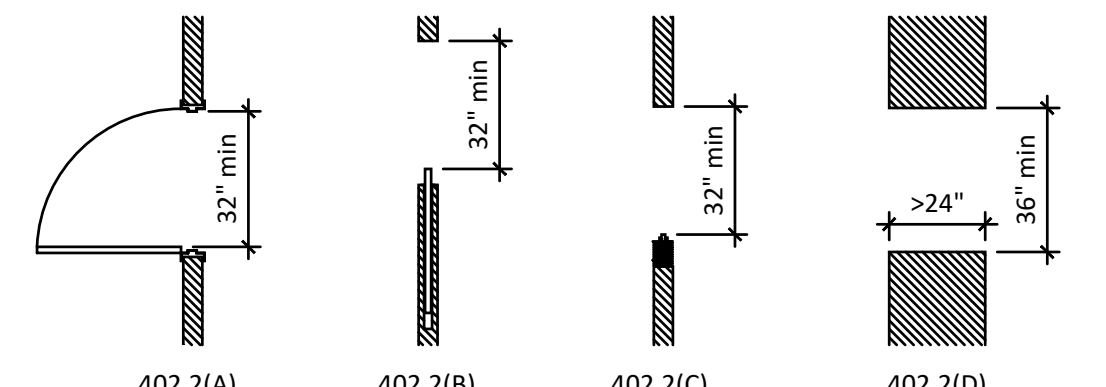


Figure(s) 402.2 Clear Width of Doorways


404.2.3 Maneuvering clearances. Minimum maneuvering clearances at doors and gates shall comply with Section 404.2.3.1. Maneuvering clearances shall include the full clear opening width of the doorway and the required latch-side or hinge-side clearance.

404.2.3.1 Floor surface. The floor surface within the maneuvering clearances shall have a slope not steeper than 1:48 and shall comply with Section 302.

404.2.3.2 Swinging doors and gates. Swinging doors and gates shall have maneuvering clearances complying with Figures 404.2.3.2(A-H)

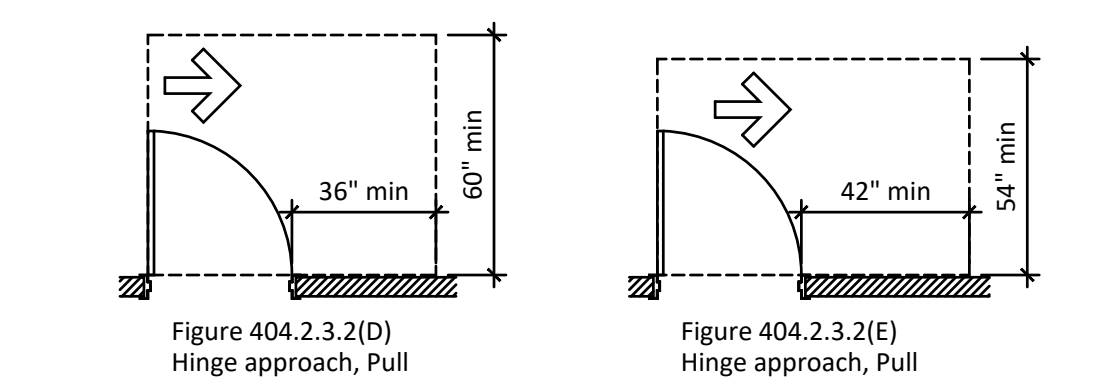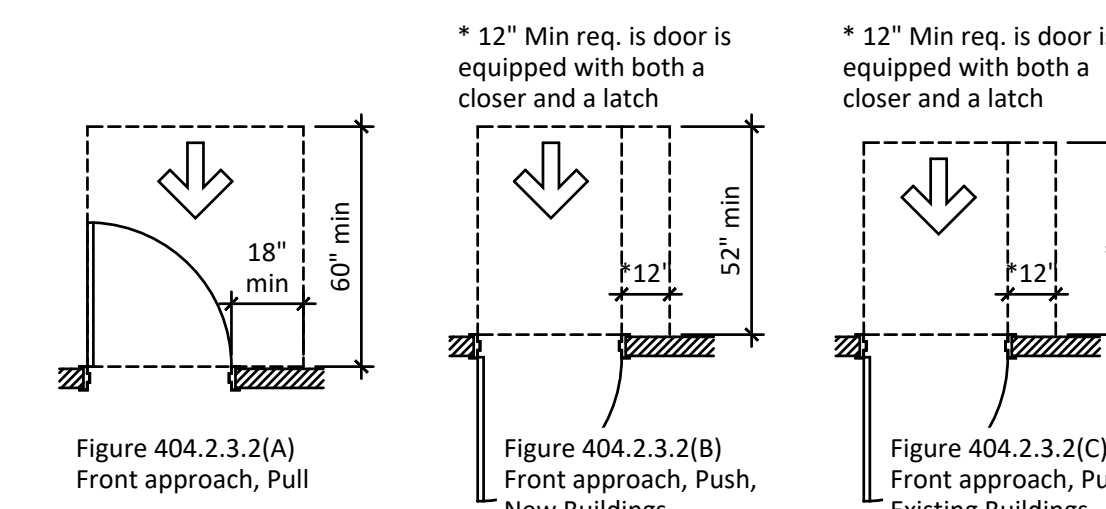

* 12" Min req. is door is equipped with both a closer and a latch

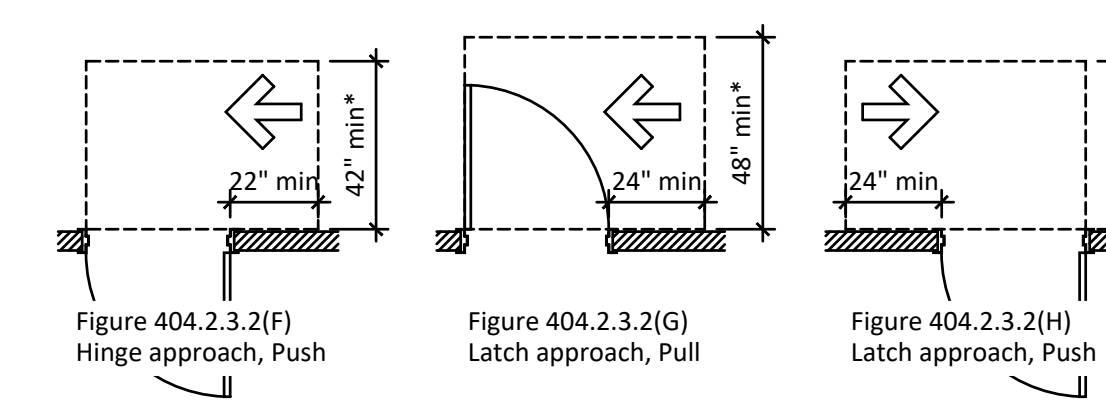

404.2.3.3 Sliding and Folding Doors. Sliding and Folding Doors shall maintain Maneuvering Clearances complying with Figures 404.2.3.3(A-D)

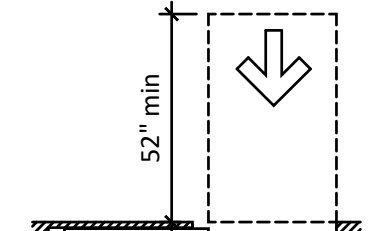


Figure 404.2.3.3(A) Front approach, New Buildings

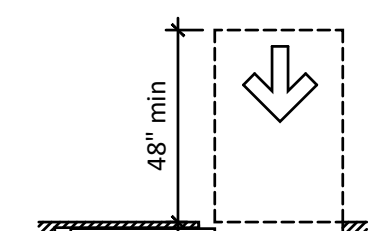


Figure 404.2.3.3(B) Front approach, Existing Buildings

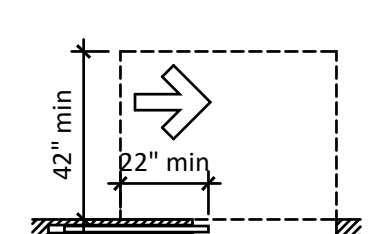


Figure 404.2.3.3(C) Pocket approach

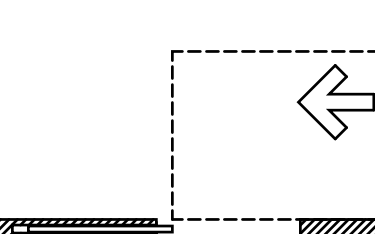


Figure 404.2.3.3(D) Latch approach

404.2.3.4 Doorways without doors or gates that are less than 36" in width shall comply with maneuvering clearances shown in Figures 404.2.3.4(A-C)

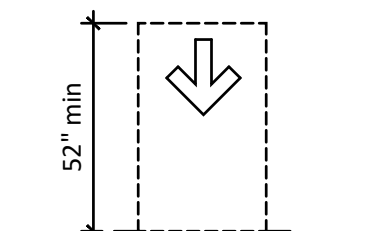


Figure 404.2.3.4(A) Front approach, New Buildings

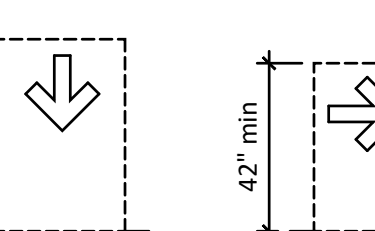


Figure 404.2.3.4(B) Front approach, Existing Buildings

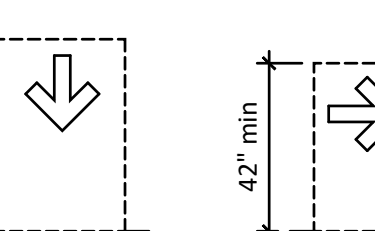


Figure 404.2.3.4(C) Side approach

404.2.3.5 Recessed doors and gates. Where any obstruction within 18 inches of the latch side of a doorway projects more than 8 inches beyond the face of the door or gate, measured perpendicular to the face of the door or gate, maneuvering clearances for a forward approach shall be provided.

404.2.5 Two doors or gates in series. Distance between two hinged or pivoted doors or gates in series shall be 48 inches minimum plus the width of any door or gate swinging into the space. The space between the doors and gates shall provide a turning space. See Figures 404.2.5(A-F)

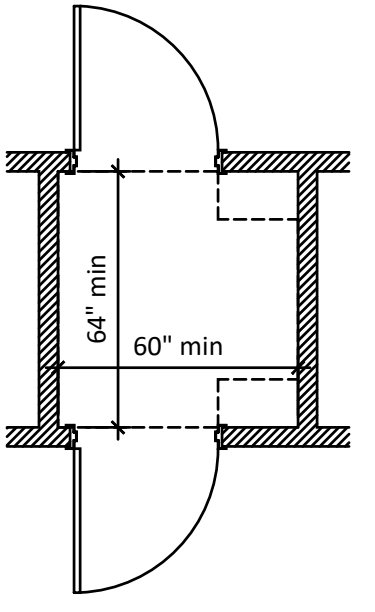


Figure 404.2.5(A) Doors in a Series - New Buildings

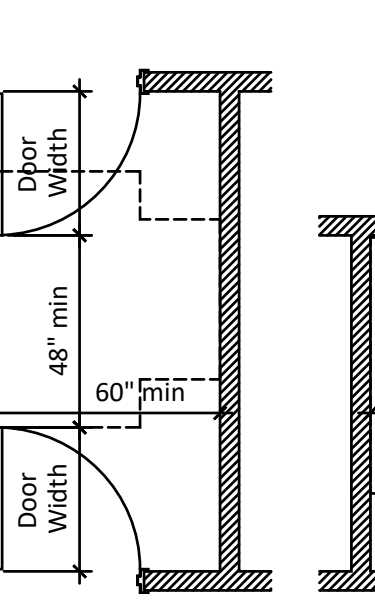


Figure 404.2.5(B) Doors in a Series - New Buildings

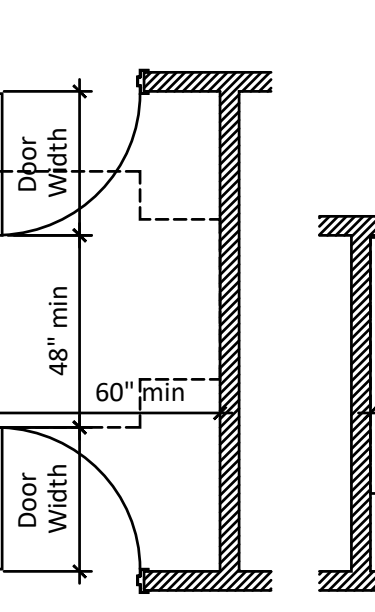


Figure 404.2.5(C) Doors in a Series - New Buildings

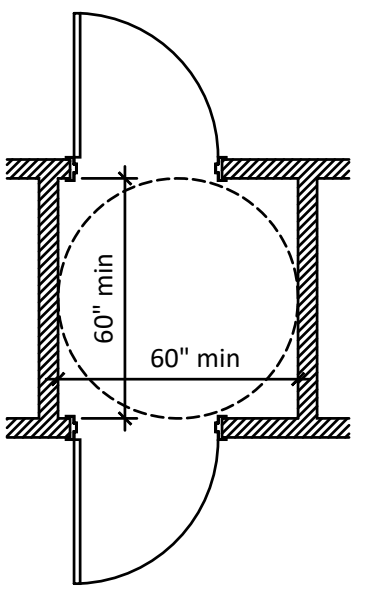


Figure 404.2.5(D) Doors in a Series - Existing Buildings

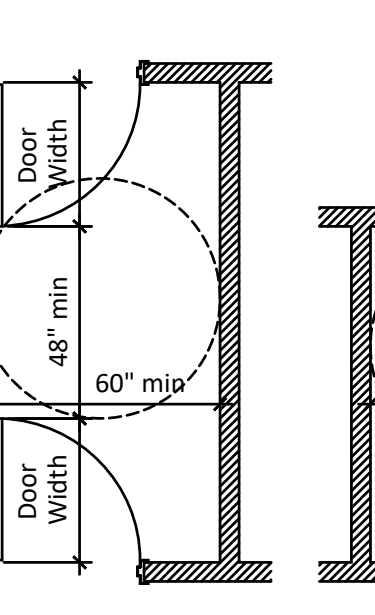


Figure 404.2.5(E) Doors in a Series - Existing Buildings

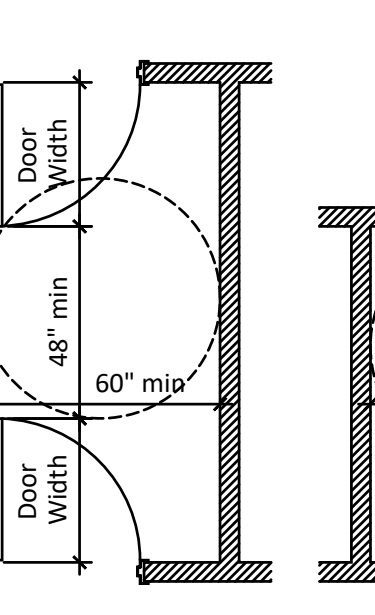


Figure 404.2.5(F) Doors in a Series - Existing Buildings

404.2.6 Door and gate hardware. Handles, pulls, latches, locks and other operable parts on doors and gates shall have a shape that is easy to grasp with one hand and does not require tight grasping, pinching or twisting of the wrist to operate. The operational force to retract latches or disengage devices that hold the door or gate in a closed position shall be as follows: 1; Hardware operation by a forward, pushing or pulling motion: 15 pounds maximum and 2; Hardware operation by a rotational motion: 28 inch-pounds maximum.

404.2.6.1 Hardware height. Operable parts of such hardware shall be 34 inches minimum and 48 inches maximum above the floor. Where sliding doors are in the fully open position, operating hardware shall be exposed and usable from both sides.


404.2.7 Closing speed. Door and gate closing speed shall comply with 404.2.7.


404.2.7.1 Door and gate closers. Door and gate closers shall be adjusted so that from an open position of 90 degrees, the time required to move the door or gate to an open position of 12 degrees shall be 5 seconds minimum.

404.2.7.2 Spring hinges. Door and gate spring hinges shall be adjusted so that from an open position of 70 degrees, the door or gate shall move to the closed position in 1.5 seconds minimum.

404.2.8 Door and gate opening force. Fire doors and doors or gates required to be equipped with panic hardware, break away features or other factors requiring higher opening force for safety reasons shall have the minimum opening force allowable in scoping provisions adopted by the appropriate administrative authority. For other doors or gates, the force for pushing or pulling open doors or gates shall be as follows:

1. Interior hinged door: 5.0 pounds maximum. 2. Sliding or folding door: 5.0 pounds maximum.

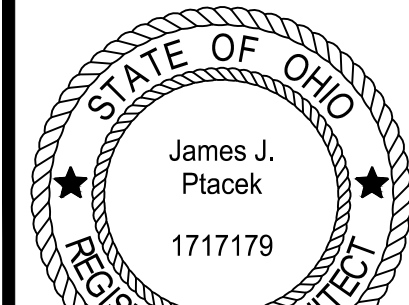

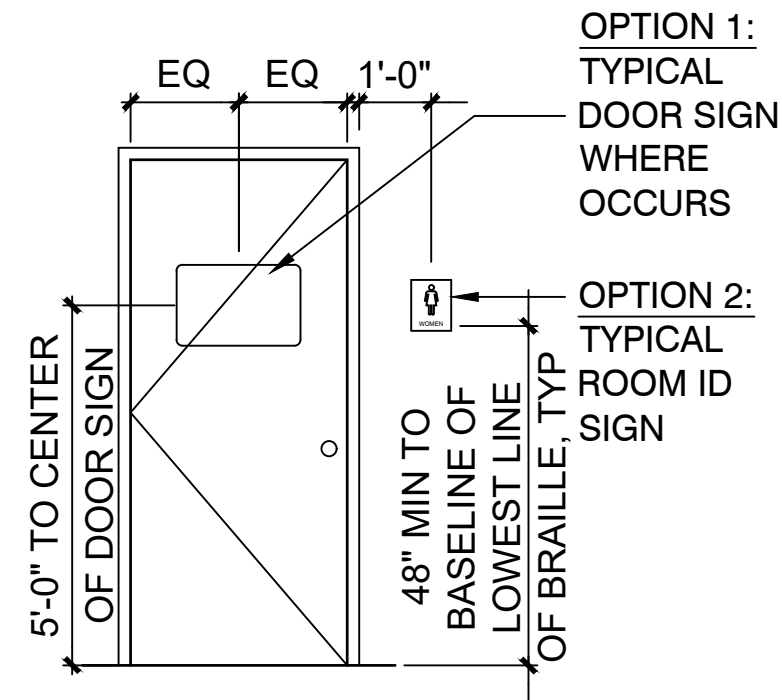



3 TYPICAL ADA COMPLIANT SIGN DETAILS
SCALE: N.T.S

NOTES:

1. DOOR SIGN: SHALL BE CENTERED ON DOOR & MOUNTED 60" ABOVE THE FLOOR (W/ADHESIVE ONLY - CAULK EDGES W/CLEAR SILICONE) @ THE CENTER OF THE SIGN.
2. ROOM SIGN: RAISED & BRAILLED CHARACTERS & PICTORIAL SYMBOL SIGNS (PICTOGRAMS). LETTERS & NUMERALS SHALL BE RAISED 1/32", UPPERCASE, SANS SERIF OR SIMPLE SERIF TYPE, & SHALL BE ACCOMPANIED WITH GRADE 2 BRAILLE. RAISED CHARACTERS SHALL BE 5/8" HIGH MIN, 2" HIGH MAX.
3. FINISH CONTRAST: THE CHARACTERS & BACKGROUND OF SIGNS SHALL BE EGGSHELL, MATTE, OR OTHER NON-GLARE FINISH.

DEMOLITION KEY NOTES

- (CB) REMOVE EXISTING ELEVATED CMU LOCKER BASE CONST., LEVEL TO EXISTING CONCRETE FLOOR. PREPARE EXPOSED SUBSTRATE TO RECEIVE NEW FLOOR FINISH.
 - (CE) REMOVE CEILING GRID AS NECESSARY FOR NEW WALLS
 - (D) REMOVE EXISTING DOOR
 - (W) REMOVE WALL WHERE INDICATED ON PLAN. COORDINATE WITH NEW WORK
 - (WI) REMOVE PORTION OF WALL SYSTEM AT WINDOW LOCATIONS. SHORE NEW WINDOW OPENING AS NEEDED IN PREPARATION FOR NEW LINTELS.
 - (FN) REMOVE FURNITURE. CONFIRM WITH OWNER IF IT IS TO BE DISPOSED OF OR SAVED.
 - (CA) CAREFULLY REMOVE CABINETRY AND SAVE FOR REUSE. STORE PER OWNER'S INSTRUCTION.
 - (L) RELOCATE EXISTING LIGHT FIXTURE TO NEW LOCATION
 - (M) REMOVE/REWORK EXISTING DIFFUSERS/RETURNS PER NEW CEILING PLAN 2/A1.0. SEE HVAC PLAN
 - (PL) REWORK EXISTING PLUMBING TO CONNECT AT NEW EQUIP LOCATIONS. SEE PLUMBING DRAWINGS.
 - (RE) RELOCATE EXISTING EQUIPMENT TO NEW LOCATION. SEE PROPOSED PLAN FOR LOCATION. CONFIRM WITH OWNER
 - (SL) REMOVE PORTION OF EXISTING SLAB AS REQUIRED TO INSTALL NEW PLUMBING FIXTURES
- NOTE: REMOVE EXISTING FINISHES IN AREA OF WORK. SEE NEW FINISH SCHEDULE ON SHEET A1.0
- INDICATES WALL PARTITION DEMOLITION

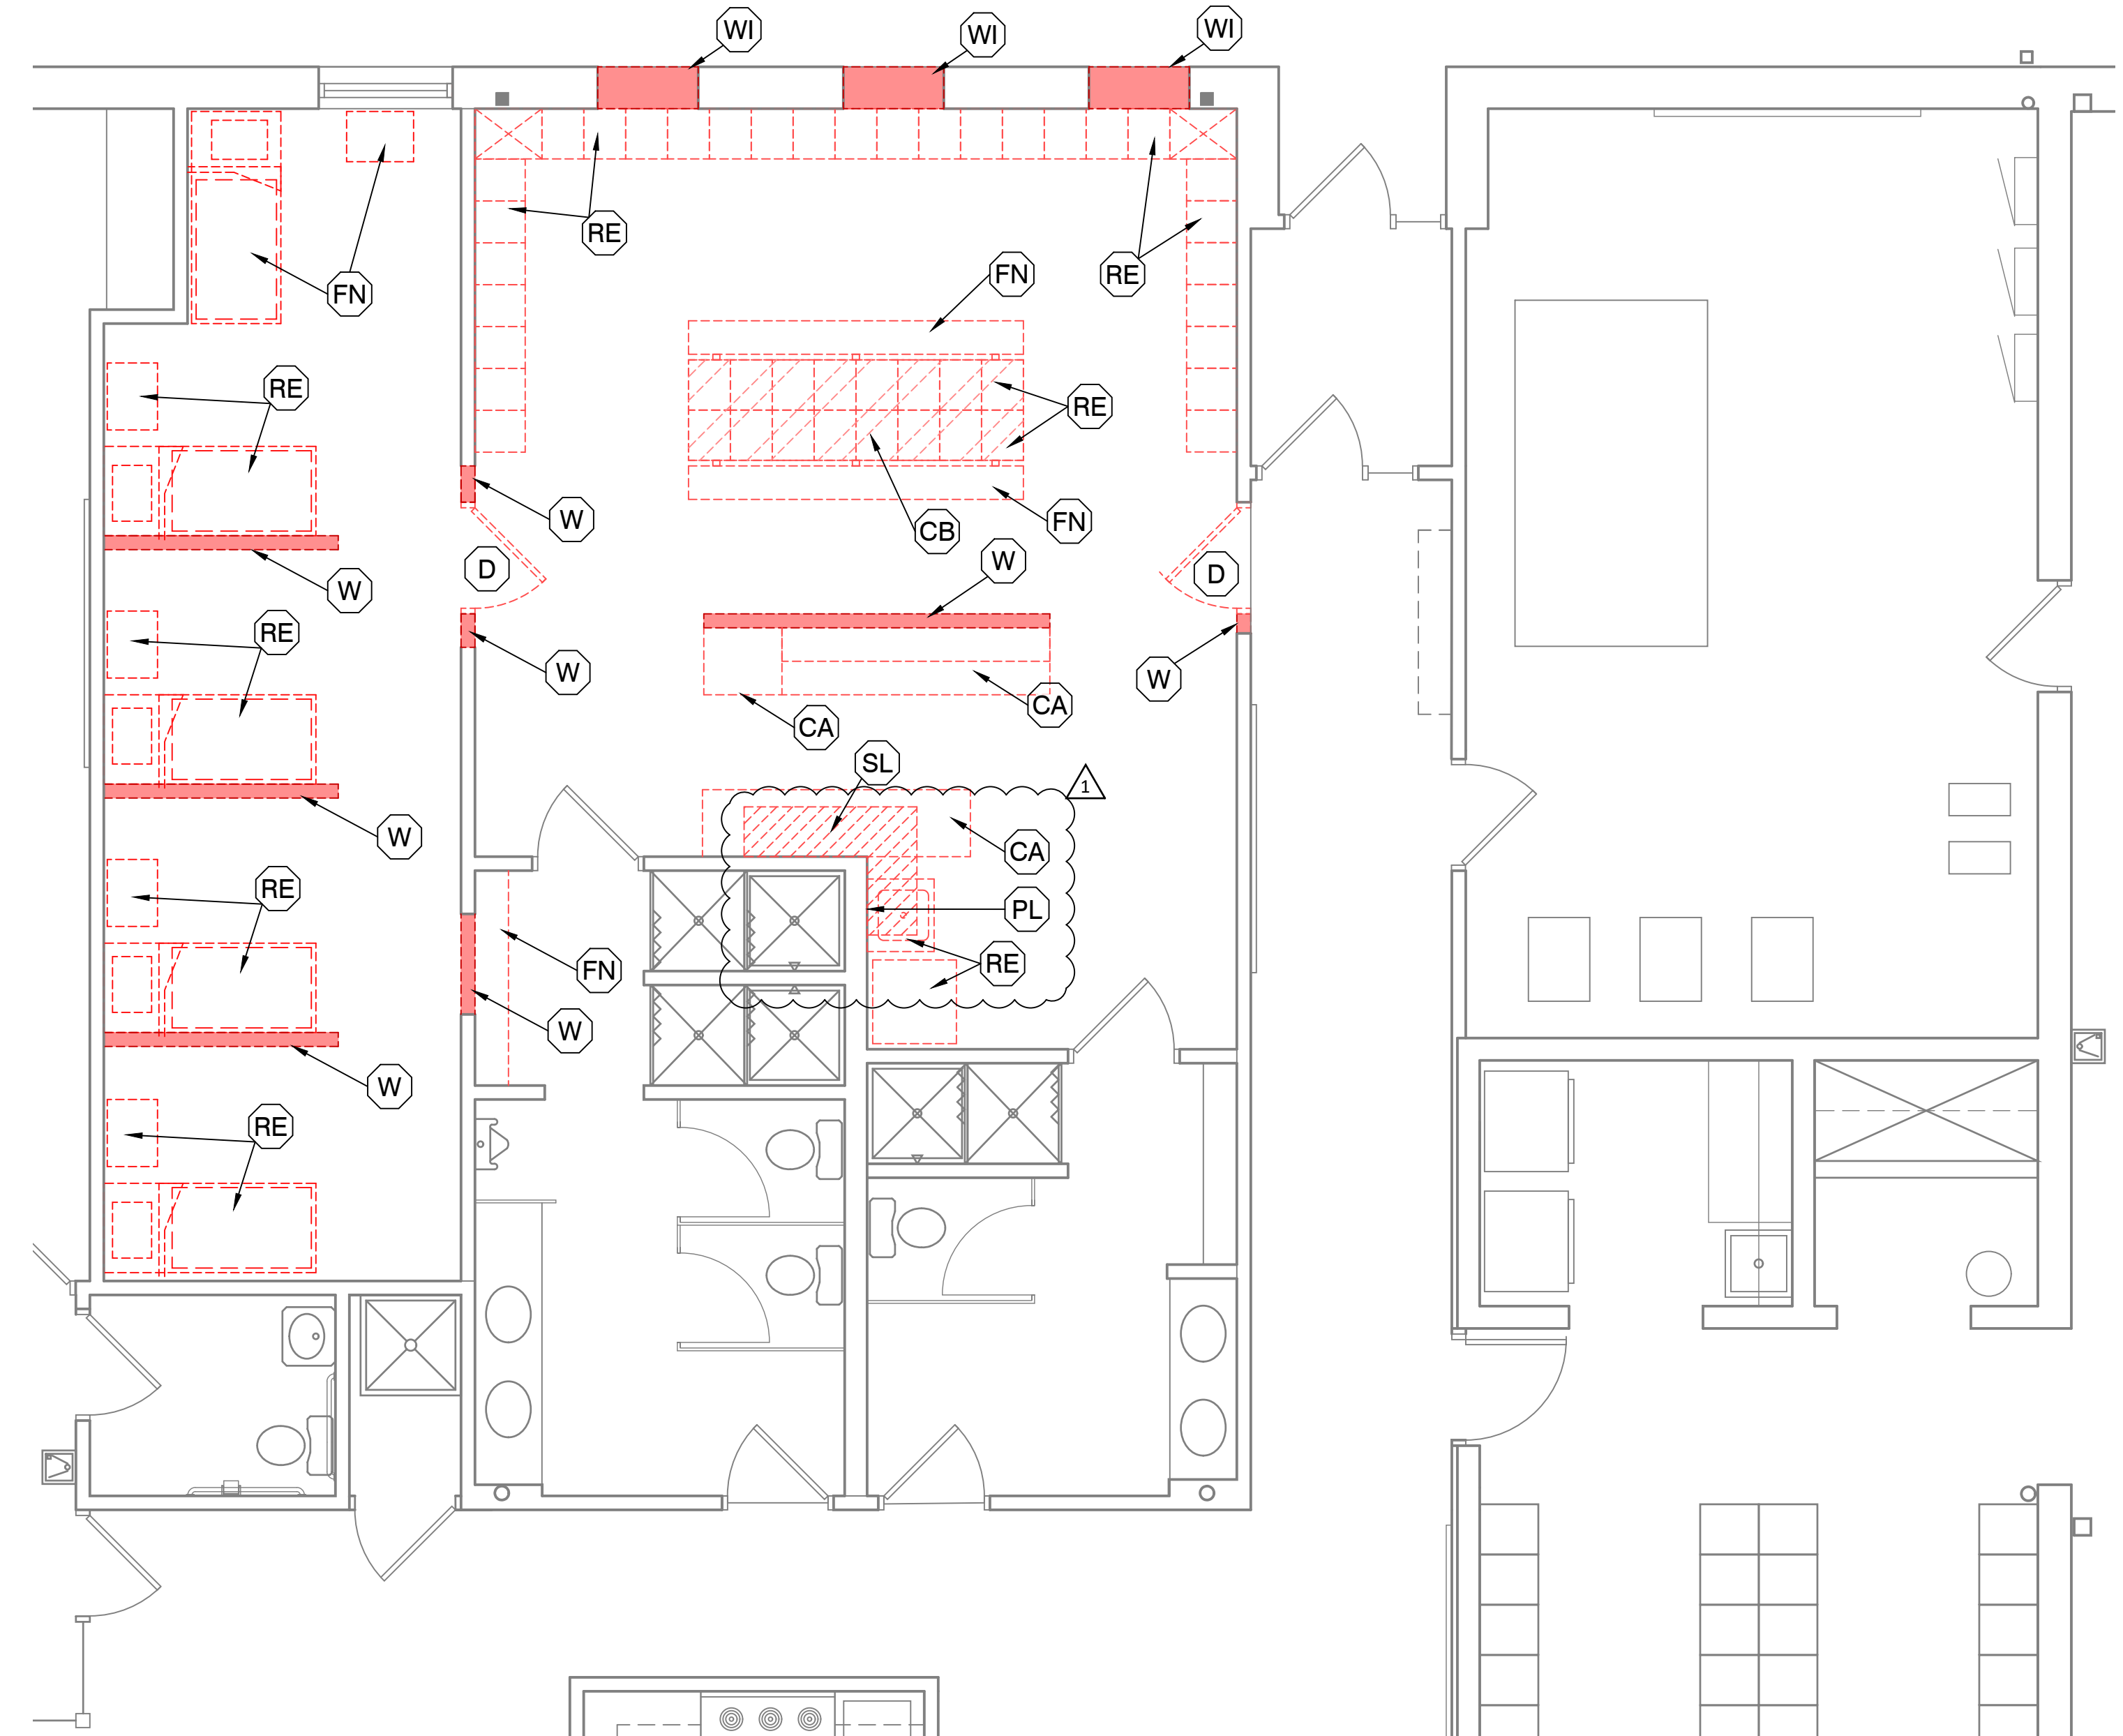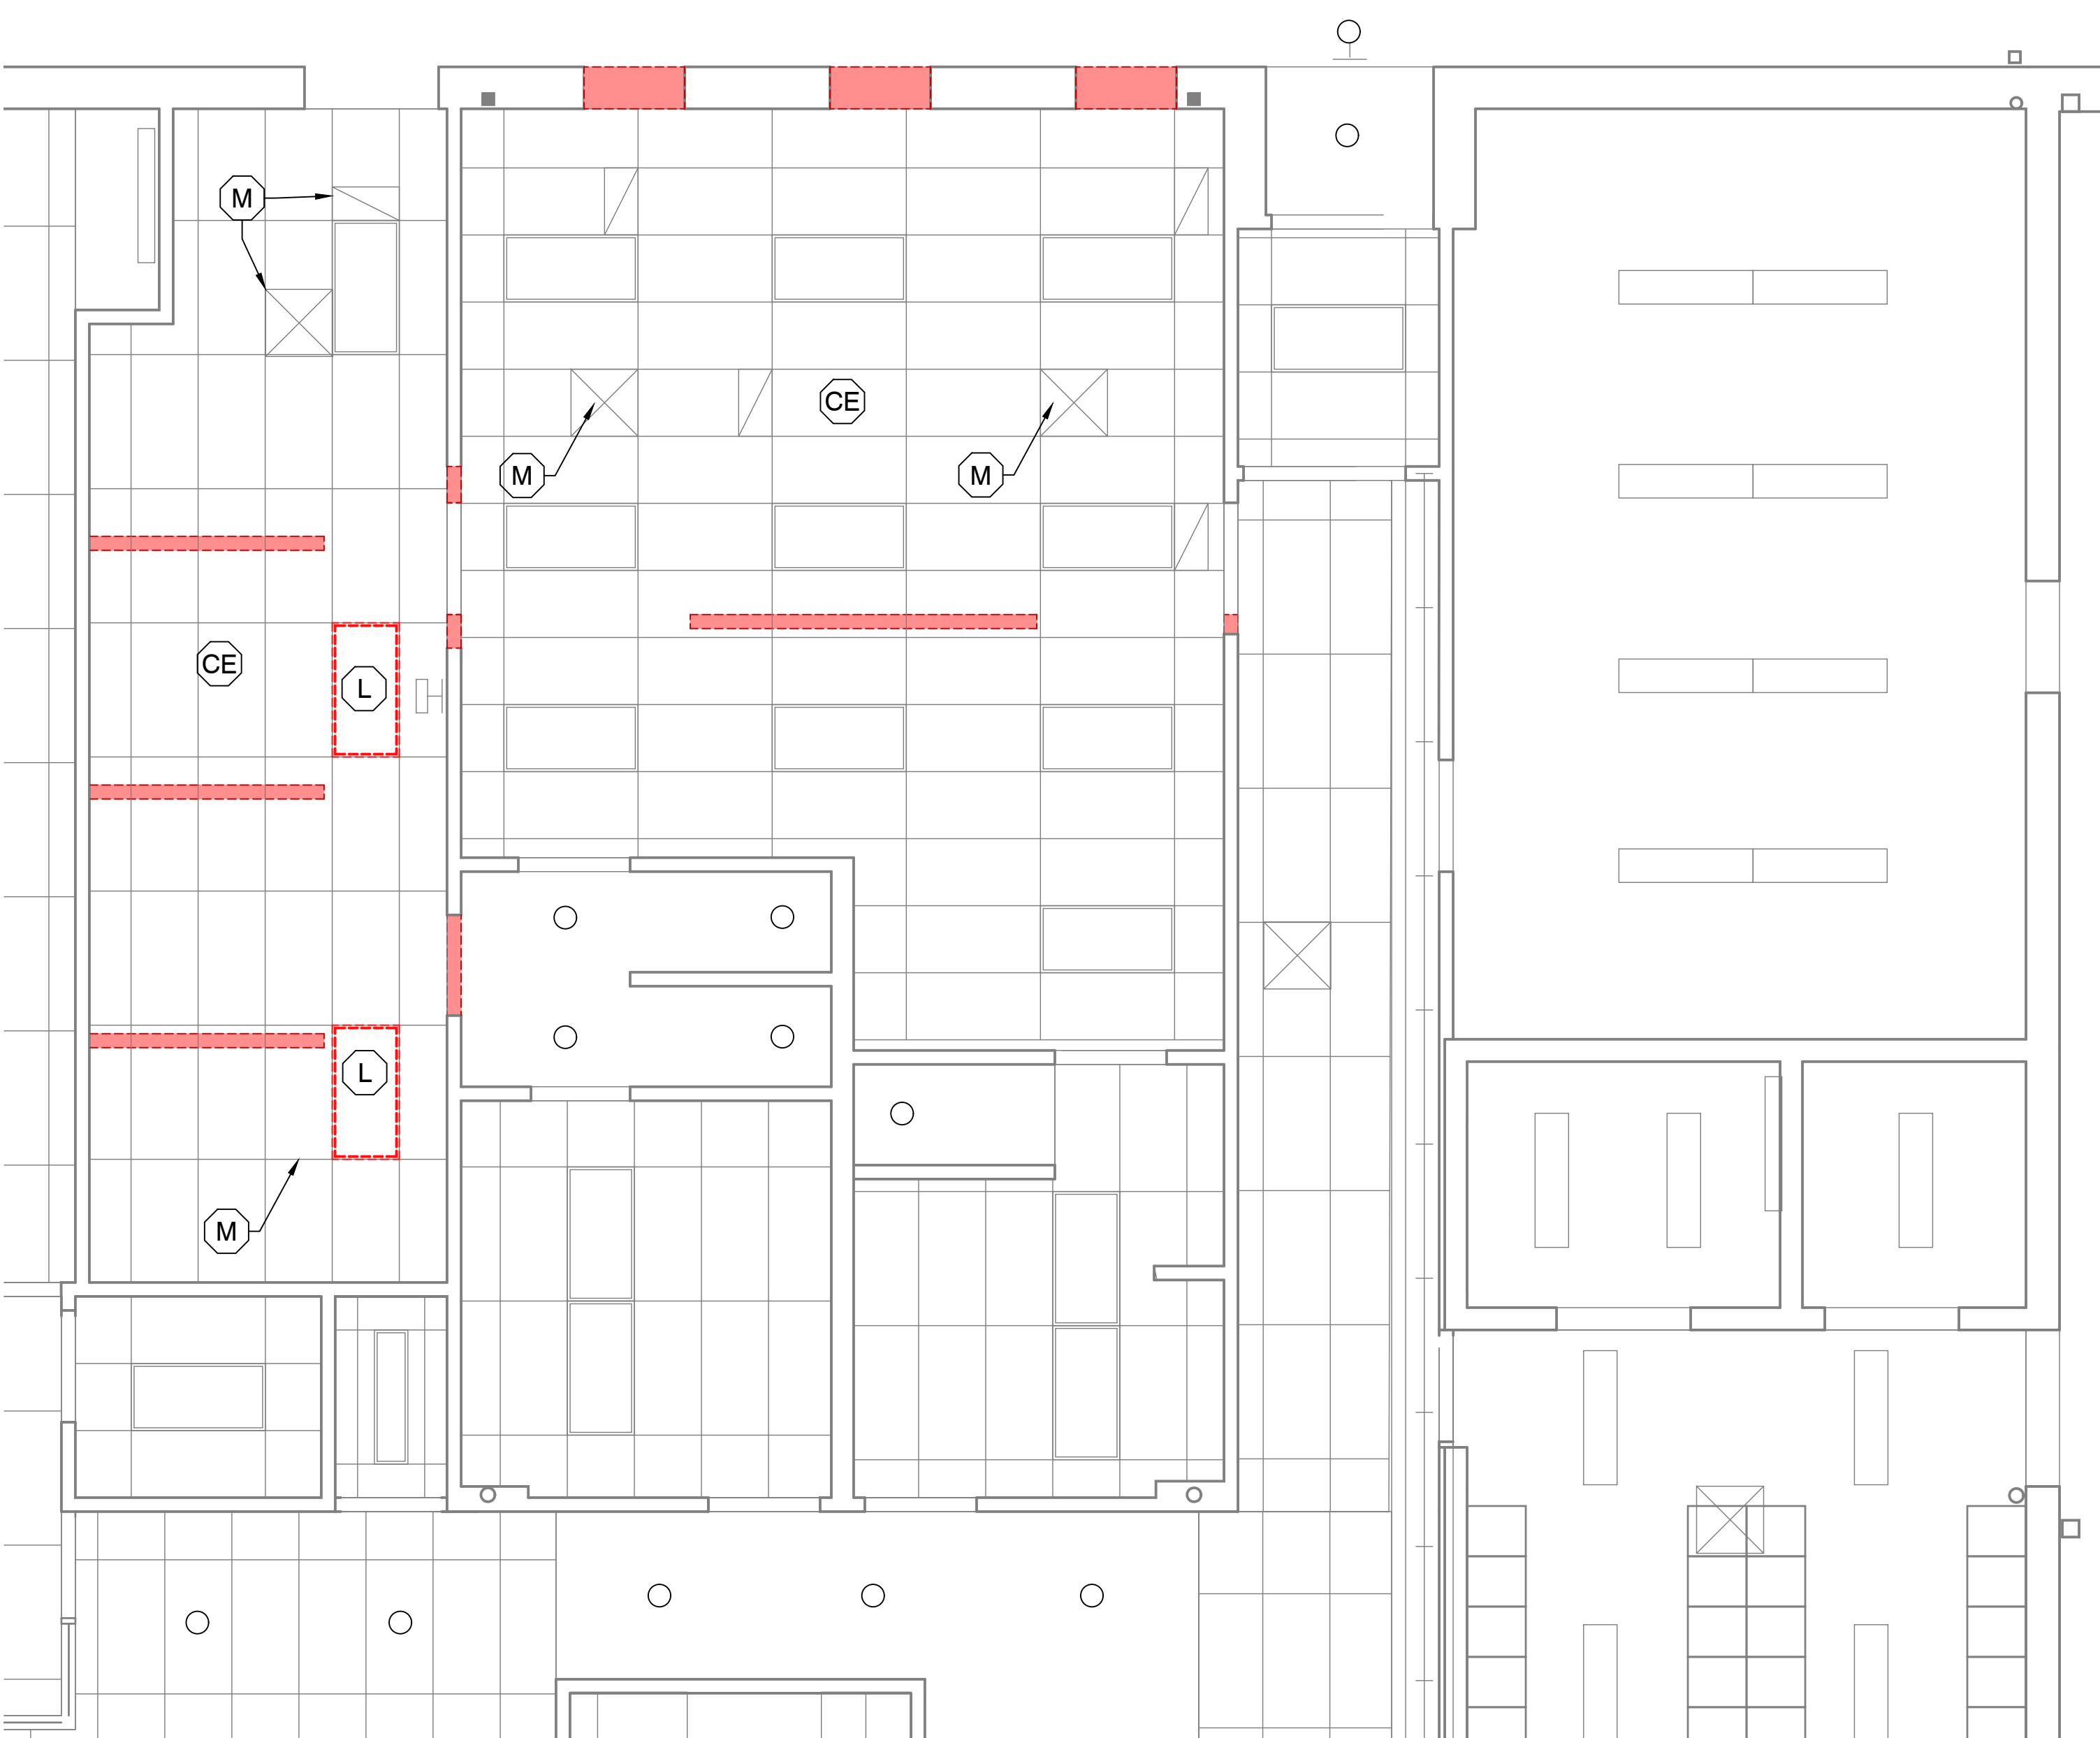

James J. Placek, License #1717179
Expiration Date 12/31/2025

LARSEN
ARCHITECTS

12815 DETROIT AVE.
LAKEWOOD, OHIO 44107
216-221-2350

PROJECT NO: 24136

FIRE DEPARTMENT
RUSSELL TOWNSHIP FIRE DEPT.
14810 CHILICOTHE RD.
NOVELTY, OH 44072

DRAWN BY: BB
CHECKED BY: JP

ISSUE
PERMIT: 2025.08.29
REVISION 1: 2025.10.31

THE CONTRACTOR AGREES THAT LARSEN ARCHITECTS SHALL BE THE FINAL DETERMINER OF THE SCOPE & INTENT OF THESE DRAWINGS.

THE CONTRACTOR SHALL VERIFY ALL CONDITIONS AND DIMENSIONS AT THE JOB SITE AND NOTIFY THE ARCHITECTS OF ANY DISCREPANCIES OR OMISSIONS BEFORE BEGINNING OR FABRICATING ANY WORK.

NO SUBSTITUTIONS ARE PERMITTED UNLESS APPROVED BY THE ARCHITECT PRIOR TO BID ACCEPTANCE.

ANY WORK PERFORMED IN CONFLICT WITH THE CONTRACT DOCUMENTS OR ANY CODE REQUIREMENTS SHALL BE CORRECTED BY THE CONTRACTOR AT HIS OWN EXPENSE.

NOTES & DETAILS ON DRAWINGS SHALL TAKE PRECEDENCE OVER GENERAL NOTES AND TYPICAL DETAILS.

ANY DUPLICATION OR MODIFICATION IS FORBIDDEN WITHOUT PRIOR WRITTEN PERMISSION FROM LARSEN ARCHITECTS.

SHEET NUMBER

D1.0
DEMOLITION PLAN

ROOM FINISHES:

GENERAL NOTES:

- FINISHES LISTED BELOW APPLY TO ALL AREAS WITHIN THE PROJECT SCOPE.
- FINISHES ARE SPECIFIED AS A BASIS-OF-DESIGN, AND MAY BE SUBSTITUTED WITH EQUAL ALTERNATES, PENDING APPROVAL BY THE ARCHITECT.
- ALL SUBSTRATES RECEIVING NEW FINISHES SHALL BE PREPARED AS REQUIRED BY THE MANUFACTURER.

FLOORING

JOHNSONITE SOLID COLOR RUBBER FLOOR TILE,
TEXTURE: FLAGSTONE
COLOR: SELECTED BY ARCHITECT FROM
MFR'S FULL LINE

WALL BASE

JOHNSONITE BASE WORKS THERMOSET RUBBER
(TYPE TS)
HEIGHT: 4"
COLOR: TO MATCH EXISTING AS CLOSE AS
POSSIBLE FROM MFR'S FULL LINE

WALL PAINT

SHERWIN WILLIAMS ZERO V.O.C. INTERIOR
LATEX PAINT
ONE PRIMER COAT (Promar 200)
TWO FINISH COATS (SuperPaint)
FINISH: EGGSHELL
COLOR: SELECTED BY ARCHITECT

CEILING:

CLEAN AND REUSE EXISTING ACT CEILING AND
SUSPENSION GRID. BRACE AND REINFORCE
GRID, AS REQUIRED, AROUND NEW WALL
LOCATIONS.

DOOR SCHEDULE AND HARDWARE

HARDWARE SETS:

100A | 101A | 102A | 103A: ROOMS A, B, C & D

- 1-1/2 PR HINGES
- ADA COMPLIANT SURFACE CLOSER
- 1 WALL STOP
- GASKETING
- THRESHOLD (ADA COMPLIANT)
- ADA COMPLIANT PRIVACY LOCKSET (*always allows security and free egress*).

104A: COMMON ROOM


- 20 MIN. RATED DOOR AND FRAME
- 1-1/2 PR HINGES
- ADA COMPLIANT SURFACE CLOSER
- 1 WALL STOP
- GASKETING
- THRESHOLD (ADA COMPLIANT) GROUTED SOLID
- ADA COMPLIANT STORE ROOM LOCKSET (*always unlocked from egress side*).

105A: MEN'S LOCKER ROOM

- 1-1/2 PR HINGES
- ADA / ANSI 117.1 COMPLIANT SURFACE CLOSER
- GASKETING
- ADA COMPLIANT STORE ROOM LEVER LATCH

106A: WOMEN'S LOCKER ROOM

- 1-1/2 PR HINGES
- ADA / ANSI 117.1 COMPLIANT SURFACE CLOSER
- 1 WALL STOP
- GASKETING
- THRESHOLD (ADA COMPLIANT)
- ADA COMPLIANT STORE ROOM LOCKSET (*always unlocked from egress side*).

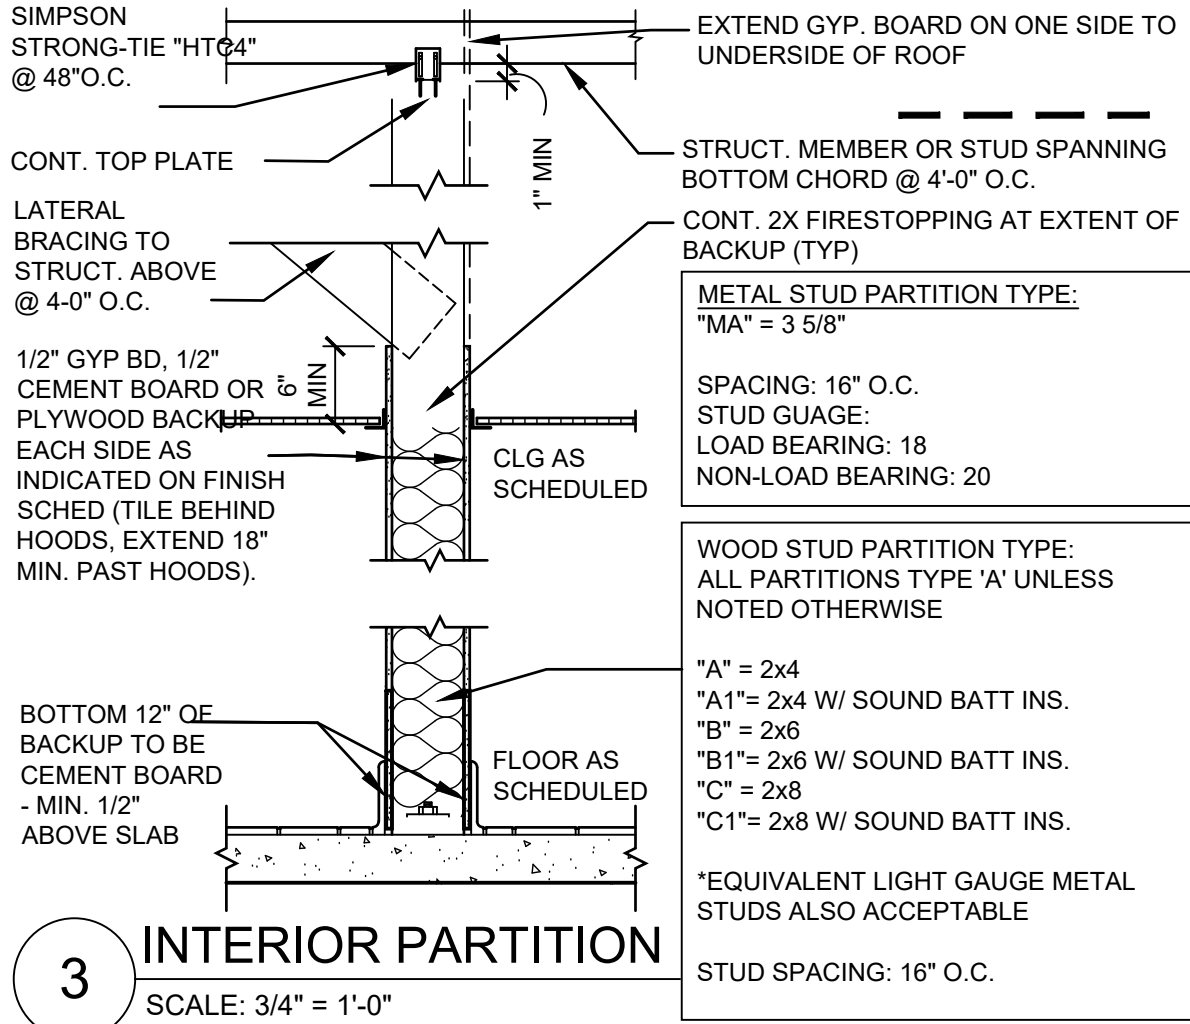

GENERAL DOOR NOTES:

- MATCH NEW DOOR, FRAME & HARDWARE FINISHES TO EXISTING ADJACENT INSTALLATIONS
- VERIFY ALL NEW HARDWARE KEYING REQUIREMENTS WITH OWNERSHIP

KEY NOTES

- NEW CALL INDICATOR LIGHT BY OWNER. CONDUIT AND JUNCTION BOX BY E.C.
- PROVIDE ONE(1) DOMESTIC SPRINKLER HEAD IN EACH SLEEPING ROOM. SEE MEP DWG
- ADA / ANSI 117.1 COMPLIANT WALL MOUNTED TACTILE EXIT SIGN
- WALL MOUNTED SIGN TO INDICATE: MAXIMUM 18 OCCUPANTS
- NEW WIRE SHELVES PROVIDED BY OWNER - 42x18x54
- NEW EMERGENCY LIGHTING AND EXIT SIGN
- RELOCATED LIGHTS - SEE ELECT. DWG.
- LOCKERS:

NOTE: PROVIDE CONCEALED STRUCTURAL WALL BLOCKING AT ALL LOCKER LOACTIONS.

- NEW FULL HEIGHT FLOOR MOUNTED METAL LOCKERS BY PENKO PRODUCTS OR EQUAL.
CONTACT: ADAM LEMKE (757) 814-3088;
Adam.Lemke@pencoproducts.com
- RELOCATED EXISTING FULL HEIGHT LOCKERS, FLOOR MOUNTED
- RELOCATED EXISTING SHORT HEIGHT LOCKERS, WALL MOUNTED, OPEN BELOW

NEW MECHANICAL DIFFUSERS - SEE MECH. DWG. FOR DUCTWORK MODIFICATIONS

RELOCATED EQUIPMENT

NEW RECESSED CEILING MOUNTED SPEAKER BY OWNER. CONDUIT AND JUNCTION BOX BY E.C.

NEW ALUMINUM DOUBLE HUNG EGRESS WINDOW:


- BASED ON EFCO SERIES 690 DOUBLE HUNG/TILT WINDOW
- INSTALLED PER MANUFACTURER'S INSTRUCTIONS
- FINISH - WHITE
- MIN U-FACTOR 0.30
- 1" INSULATED GLASS
- THERMALLY BROKEN FRAME
- INCLUDE FULL SCREENS
- VERIFY MINIMUM CLEAR OPENING SIZE: 5.7 S.F. (24" CLEAR HEIGHT OPENING)
- AT NEW WINDOW OPENINGS, PROVIDE NEW 4x4x3/8" STEEL ANGLE LINTEL FOR BRICK WITH 6" BEARING EA. SIDE. PROVIDE L-HEADER (OR EQUAL) FOR STUD FRAMING AT NEW OPENING. PROVIDE SOLID ANCHOR TO STRUCTURAL JAMBS. MAINTAIN CAVITY AIR SPACE. PROVIDE CONT. FLASHING AND WEEP HOLES.

REWORKED SUPPLY / DRAIN. PROVIDE LAUNDRY BOX AT 48" A.F.F. SEE PLUMBING DRAWINGS

REWORKED ELECTRICAL FOR LAUNDRY EQUIPMENT. PLACE OUTLETS AT 48" AFF. SEE ELECTRICAL DRAWINGS.

NEW WALL MOUNTED BROOM / MOP HOLDER AS SELECTED BY OWNER.

INDICATES NEW WALL PARTITION SEE 3/A.1.0

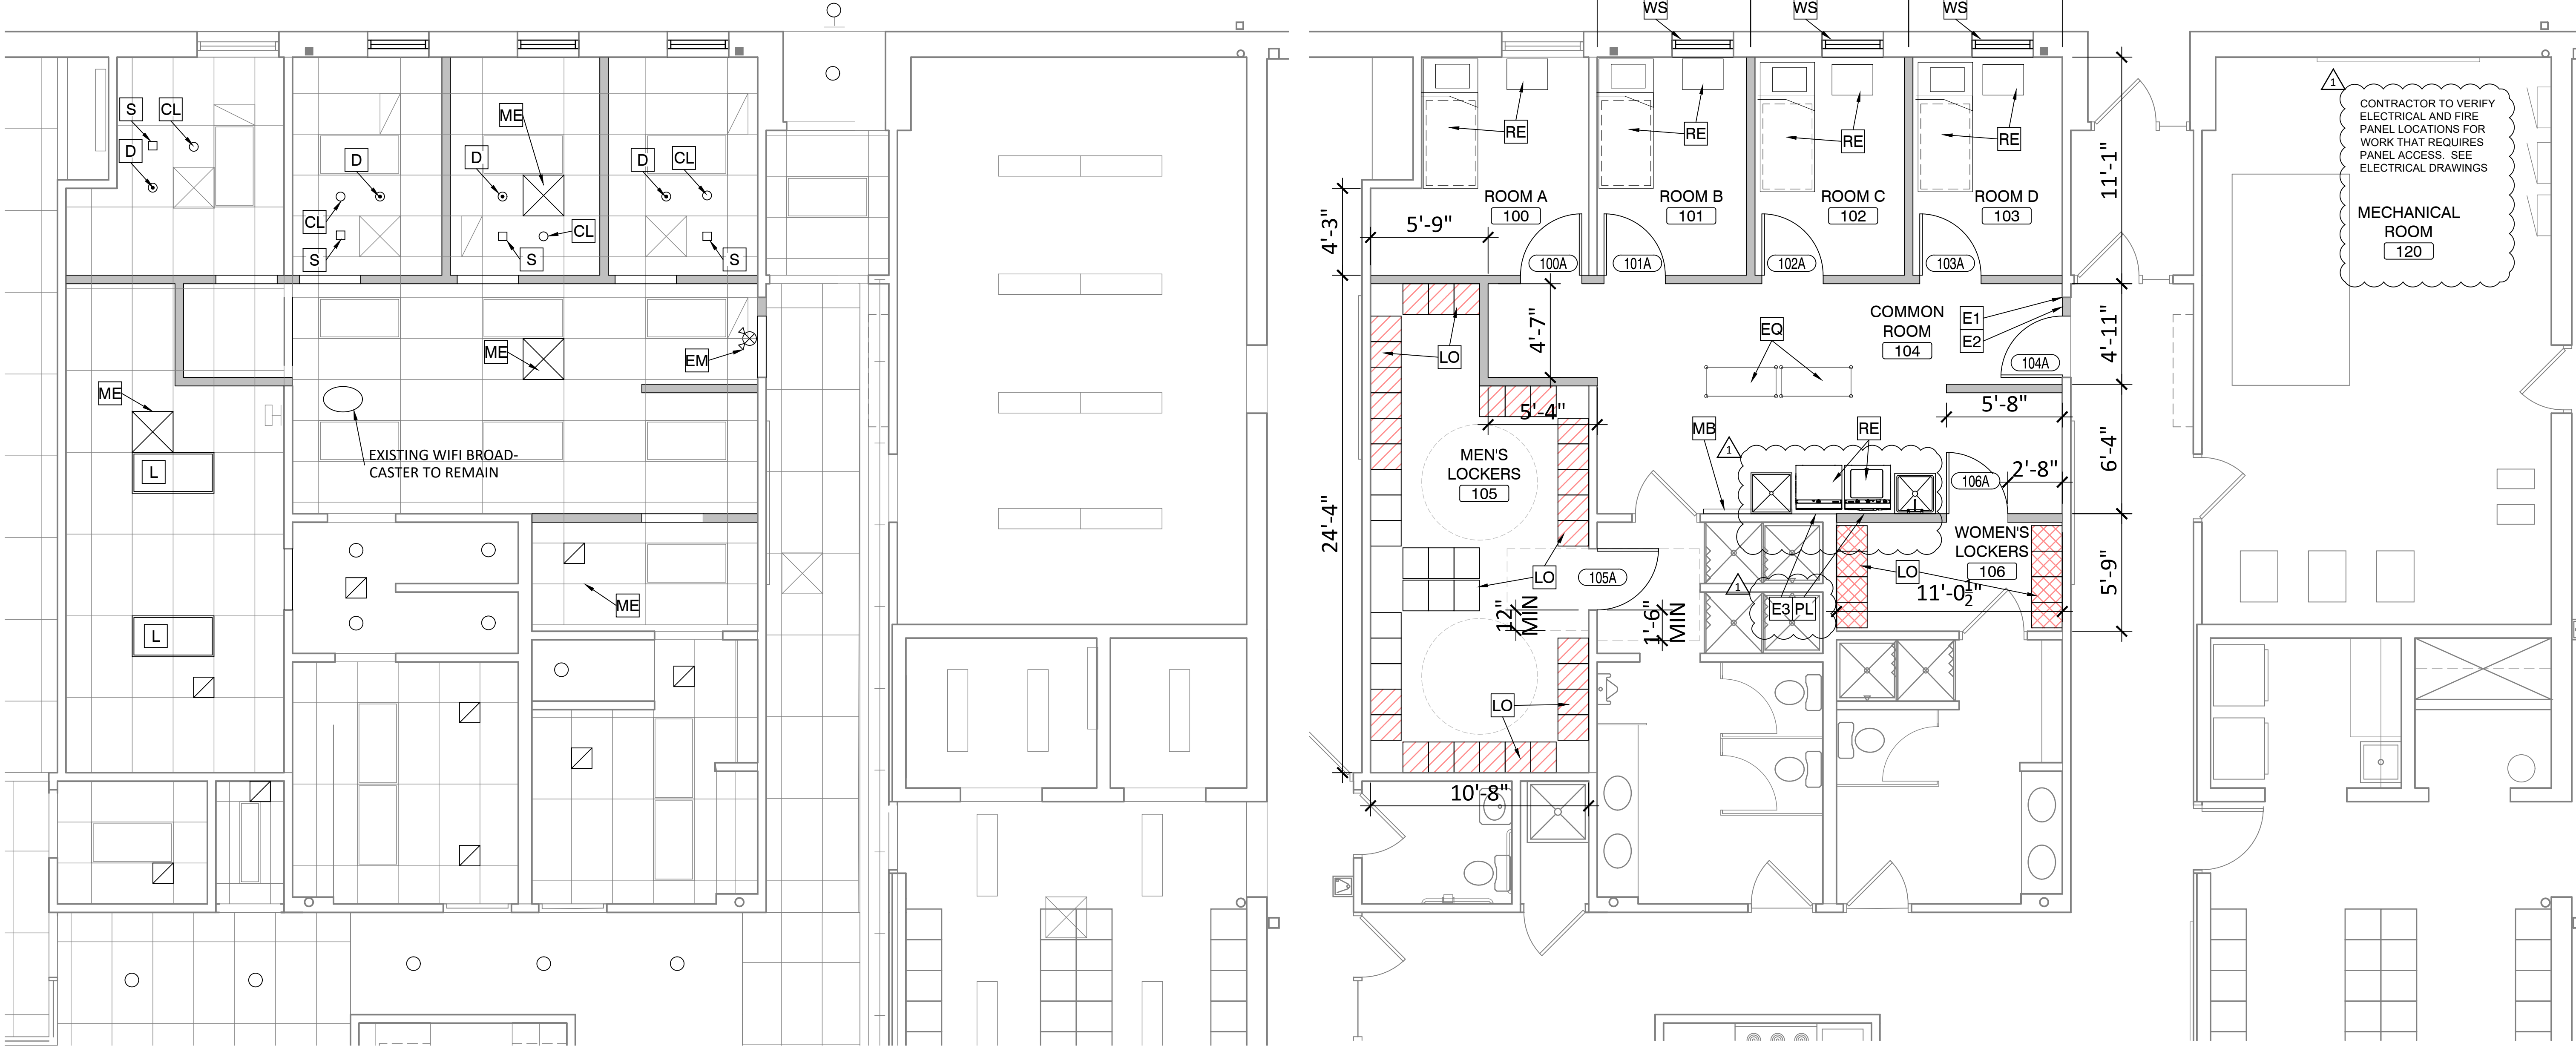

NOTE: BRACE EXISTING ACT CEILING GRID ON EACH SIDE OF NEW WALL PARTITIONS, EXTENDING TO STRUCTURAL DECK. SEE DETAIL 3/A1.0


2 REFLECTED CEILING PLAN

SCALE: 1/4" = 1'-0"


1 FLOOR PLAN

SCALE: 1/4" = 1'-0"

(NOTE: RELOCATE EXISTING SIGNAGE)

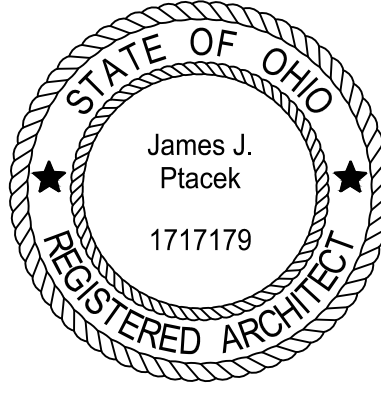

James J. Placek, License #1717179
Expiration Date 12/31/2025

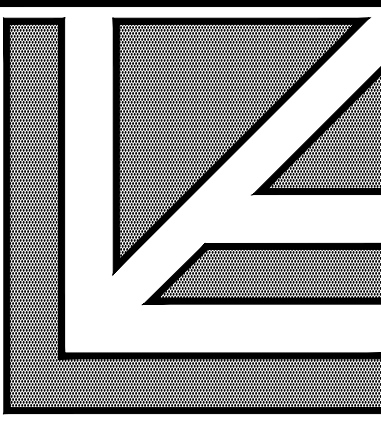

LARSEN
ARCHITECTS

12815 DETROIT AVE.
LAKEWOOD, OHIO 44107
216-221-2350

PROJECT NO: 24136

FIRE DEPARTMENT
RUSSELL TOWNSHIP FIRE DEPT.
14810 CHILICOTHE RD.
NOVELTY, OH 44072

DRAWN BY: BB
CHECKED BY: JP

ISSUE

PERMIT: 2025.08.29
REVISION 1: 2025.10.31

THE CONTRACTOR AGREES THAT LARSEN ARCHITECTS SHALL BE THE FINAL DETERMINER OF THE SCOPE & INTENT OF THESE DRAWINGS.

THE CONTRACTOR SHALL VERIFY ALL CONDITIONS AND DIMENSIONS AT THE JOB SITE AND NOTIFY THE ARCHITECTS OF ANY DISCREPANCIES OR OMISSIONS BEFORE BEGINNING OR FABRICATING ANY WORK.

NO SUBSTITUTIONS ARE PERMITTED UNLESS APPROVED BY THE ARCHITECT PRIOR TO BID ACCEPTANCE.

ANY WORK PERFORMED IN CONFLICT WITH THE CONTRACT DOCUMENTS OR ANY CODE REQUIREMENTS SHALL BE CORRECTED BY THE CONTRACTOR AT HIS OWN EXPENSE.

NOTES & DETAILS ON DRAWINGS SHALL TAKE PRECEDENCE OVER GENERAL NOTES AND TYPICAL DETAILS.

ANY DUPLICATION OR MODIFICATION IS FORBIDDEN WITHOUT PRIOR WRITTEN PERMISSION FROM LARSEN ARCHITECTS.

SHEET NUMBER


A1.0
PROPOSED PLAN

HVAC LEGEND	
ABBREVIATION	DESCRIPTION
	return or exhaust duct
	supply duct
	turning vanes
	volume damper
	existing ductwork
	existing ductwork to be removed
	sensor
	undercut door
	airflow direction
12/4	indicates square duct 12" wide by 4" tall
8"	indicated an 8" round duct
cte	connect to existing
dn	down
e	exhaust grille
ea	exhaust air
ec	electrical contractor
ef	exhaust fan
etr	existing to remain
mc	mechanical contractor
oa	outside air
pc	plumbing contractor
ra	return air
rex	remove existing
s	supply grille or diffuser
sa	supply air
typ	typical
typ-3	typical of three

PLUMBING LEGEND	
ABBREVIATION	DESCRIPTION
	shut off valve
	existing piping
	existing piping to be removed
	remove to point and cap
	remove to point for reconnection
co	clean out at floor
	floor drain/sink
	branch piping off bottom
	branch piping off top
	pipe drop
	pipe rise
CW	cold water piping
G	7-14" water column pressure gas piping
HW	hot water piping
SAN	sanitary sewer piping
SAN	sanitary sewer piping below floor
V	vent piping
cte	connect to existing
cw	cold water (domestic)
dn	down
ec	electrical contractor
etr	existing to remain
hw	hot water (domestic)
l	lavatory
lb	laundry box
lt	laundry tub
mb	mop basin
mc	mechanical contractor
pc	plumbing contractor
rex	remove existing
typ	typical
typ-3	typical of three

PLUMBING FIXTURE SCHEDULE							
designation	description	mounting	hw	cw	san	vent	model
lb-l	laundry box	wall	1/2"	1/2"	2"	1-1/2"	oatey quadro single lever washing machine outlet box, single lever hammer ball valve, 2" drain, faceplate, side brackets, 8.4" x 8.6" tall x 6.1/3" deep
lt-l	laundry tub	floor	1/2"	1/2"	1-1/2"	1-1/2"	florestone model 20fm, one piece molded tub, heavy duty legs, integral molded drain, soap dish, 20 gallon capacity, 20"x24"x35"
mb-l	mop basin	floor	1/2"	1/2"	3"	1-1/2"	florestone model 80/81/82/83, one piece terrazzo, 12" deep, 32"x32", integral molded cast brass drain with strainer, provide model fitting project application
							fixture
							faucet: chrome plated brass, deck mounted, 4" centers, 6" tubular swing spout, 3" vr-lever handles, garden hose threaded outlet, delta commercial 27e4383
							faucet: chrome plated brass, wall mounted threaded spout, bucket hook, vacuum breaker, wall brace, cast brass 4" vr-lever handles, delta commercial 28e8182

- remarks
1. refer to specifications.
 2. refer to architectural plans for all mounting heights.
 3. all plumbing fixtures shall have final approval by owner.
 4. provide all stops, escutcheons, traps, hangers, etc. for complete working installation.
 5. connection sizes are as designated unless indicated other wise on plans.

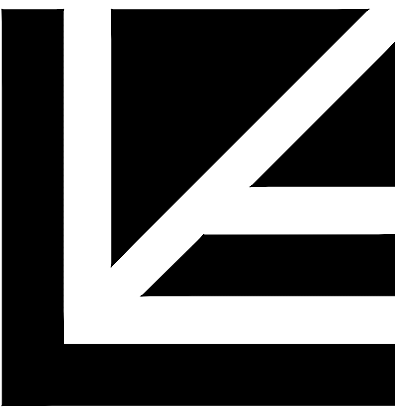

LARSEN
ARCHITECTS

12815 DETROIT AVE,
LAKEWOOD, OHIO 44107
216-221-2350

PROJECT No: 25118

FIRE DEPTARTMENT
RUSSELL TOWNSHIP FIRE DEPT.
14810 CHILICOTHE RD.
NOVELTY, OH 44072

DRAWN BY: na
CHECKED BY: sjg

ISSUE
Issued for
Permit: 2025.08.29
Permit: 2025.10.31

THE CONTRACTOR AGREES THAT LARSEN ARCHITECTS SHALL BE THE FINAL DETERMINER OF THE SCOPE & INTENT OF THESE DRAWINGS.

THE CONTRACTOR SHALL VERIFY ALL CONDITIONS AND DIMENSIONS AT THE JOB SITE AND NOTIFY THE ARCHITECTS OF ANY DISCREPANCIES OR OMISSIONS BEFORE BEGINNING OR FABRICATING ANY WORK.

NO SUBSTITUTIONS ARE PERMITTED UNLESS APPROVED BY THE ARCHITECT PRIOR TO BID ACCEPTANCE.

ANY WORK PERFORMED IN CONFLICT WITH THE CONTRACT DOCUMENTS OR ANY CODE REQUIREMENTS SHALL BE CORRECTED BY THE CONTRACTOR AT HIS OWN EXPENSE.

NOTES & DETAILS ON DRAWINGS SHALL TAKE PRECEDENCE OVER GENERAL NOTES AND TYPICAL DETAILS.

ANY DUPLICATION OR MODIFICATION IS FORBIDDEN WITHOUT PRIOR WRITTEN PERMISSION FROM LARSEN ARCHITECTS.



www.elementaleng.net
Ee
440.466.0087

elemental engineering llc

SHEET NUMBER

M0.1

LEGENDS & SCHEDULES

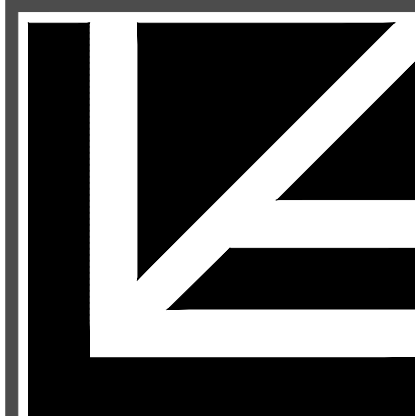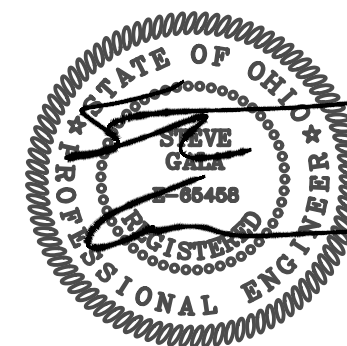

LARSEN
ARCHITECTS

12815 DETROIT AVE,
LAKEWOOD, OHIO 44107
216-221-2390

PROJECT No: 25118

FIRE DEPTARTMENT
RUSSELL TOWNSHIP FIRE DEPT.
14810 CHILICOTHE RD.
NOVELTY, OH 44072

DRAWN BY: na
CHECKED BY: sjg

ISSUE
Issued for Permit: 2025.08.29
Permit: 2025.10.31

THE CONTRACTOR AGREES THAT LARSEN ARCHITECTS SHALL BE THE FINAL DETERMINER OF THE SCOPE & INTENT OF THESE DRAWINGS.

THE CONTRACTOR SHALL VERIFY ALL CONDITIONS AND DIMENSIONS AT THE JOB SITE AND NOTIFY THE ARCHITECTS OF ANY DISCREPANCIES OR OMISSIONS BEFORE BEGINNING OR FABRICATING ANY WORK.

NO SUBSTITUTIONS ARE PERMITTED UNLESS APPROVED BY THE ARCHITECT PRIOR TO BID ACCEPTANCE.


ANY WORK PERFORMED IN CONFLICT WITH THE CONTRACT DOCUMENTS OR ANY CODE REQUIREMENTS SHALL BE CORRECTED BY THE CONTRACTOR AT HIS OWN EXPENSE.

NOTES & DETAILS ON DRAWINGS SHALL TAKE PRECEDENCE OVER GENERAL NOTES AND TYPICAL DETAILS.

ANY DUPLICATION OR MODIFICATION IS FORBIDDEN WITHOUT PRIOR WRITTEN PERMISSION FROM LARSEN ARCHITECTS.

SHEET NUMBER

M1.0
DEMO & NEW PLANS

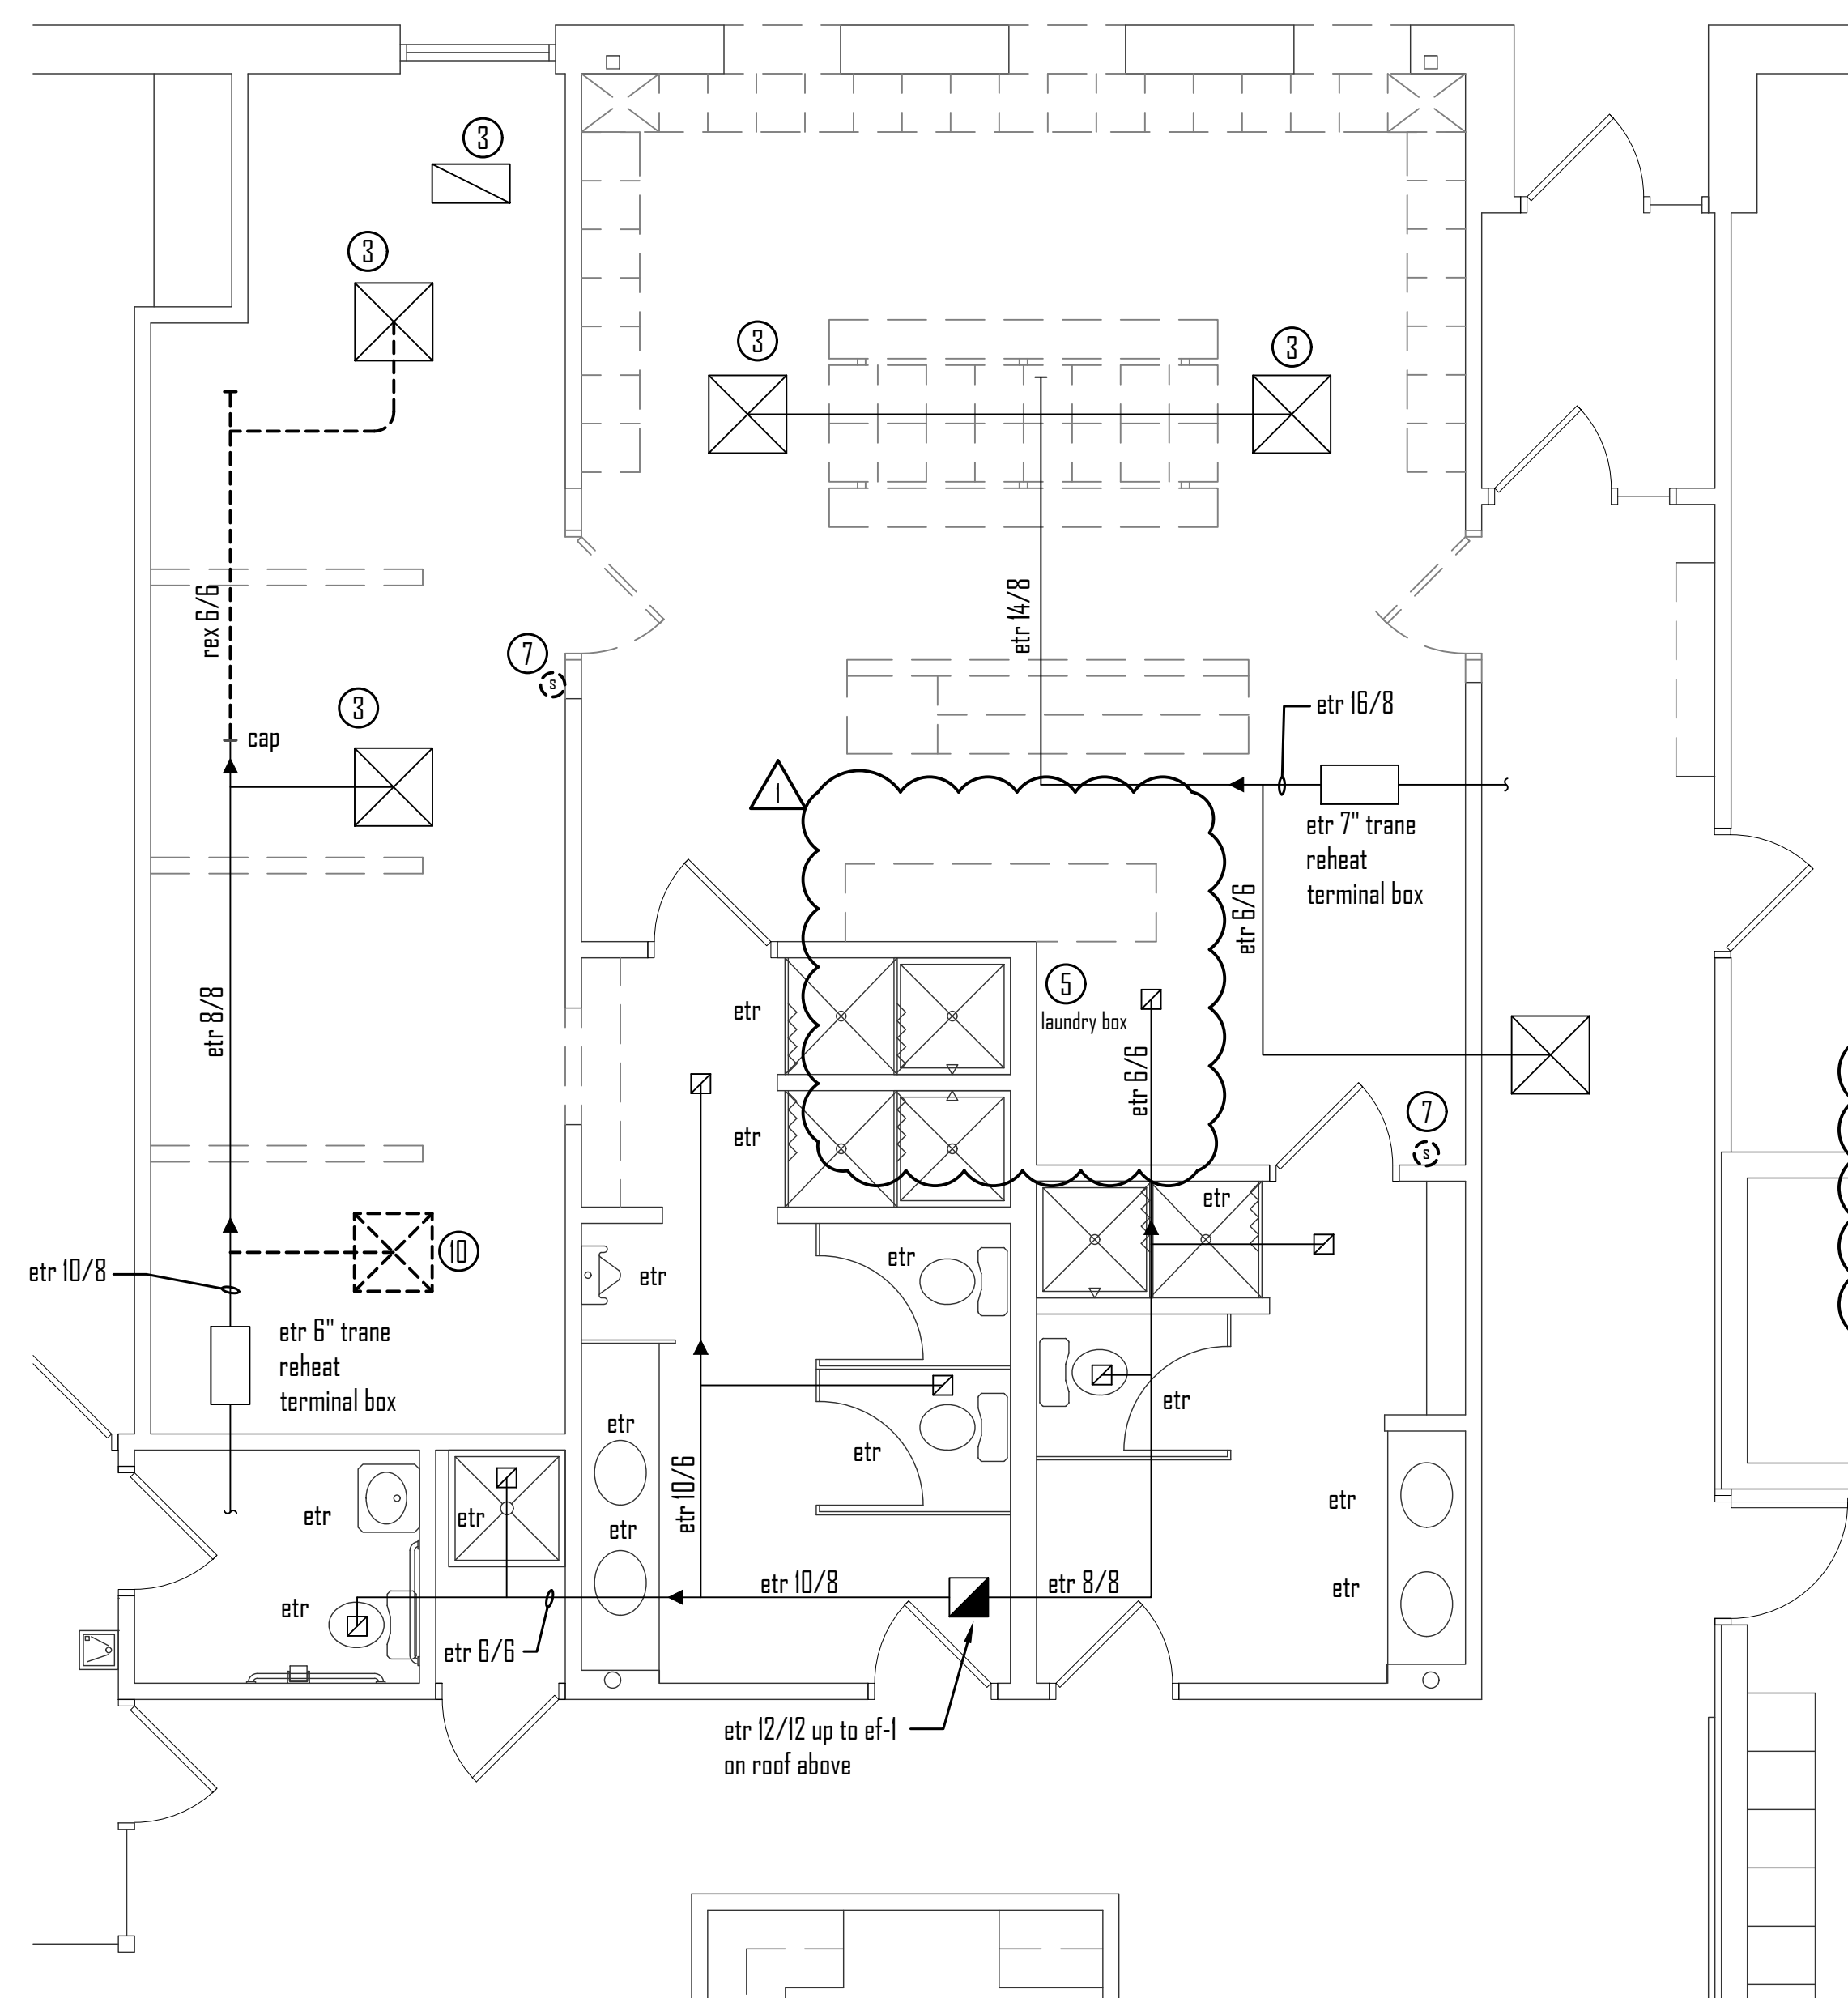


DEMOLITION PLAN
scale: 1/4" = 1'-0"


PLAN NOTES

- 1 etr diffuser, balance to air quantity indicated in cfm.
- 2 provide new diffuser to match existing, balance to air quantity listed in cfm.
- 3 etr grille/diffuser.
- 4 relocated temp sensor, extend wiring as required.
- 5 rex fixture and all associated piping to concealed location.
- 6 rex laundry tub and associated piping for relocation.
- 7 rex temp sensor for relocation.
- 8 extend drain and water lines from removed sink location to new. field verify extent of work. provide new lb-l.
- 9 provide 4" dryer vent extend and cte roof penetration, extend 3/4" g from old dryer location to new.
- 10 rex grille and all associated duct back to main.
- 11 provide new exhaust grille to match existing, balance to air quantity indicated in cfm.
- 12 provide ra grille to match existing.
- 13 provide single sprinkler head in room.
- 14 1" cw with code approved back flow preventer to main of adequate size and capacity. field verify exact routing and tie-in point.
- 15 provide new fixture as indicated, provide with 1/2" hw/cw from existing lines in vicinity. field verify exact routing and tie-in point. refer to stack 'a'.
- 16 provide new fixture as indicated, provide with 1/2" hw/cw from existing lines in vicinity. field verify exact routing and tie-in point. refer to stack 'b'.
- 17 extend and cte main of adequate size and capacity. field verify exact routing and tie-in point.

note: code required outside air is controlled via central air handling unit

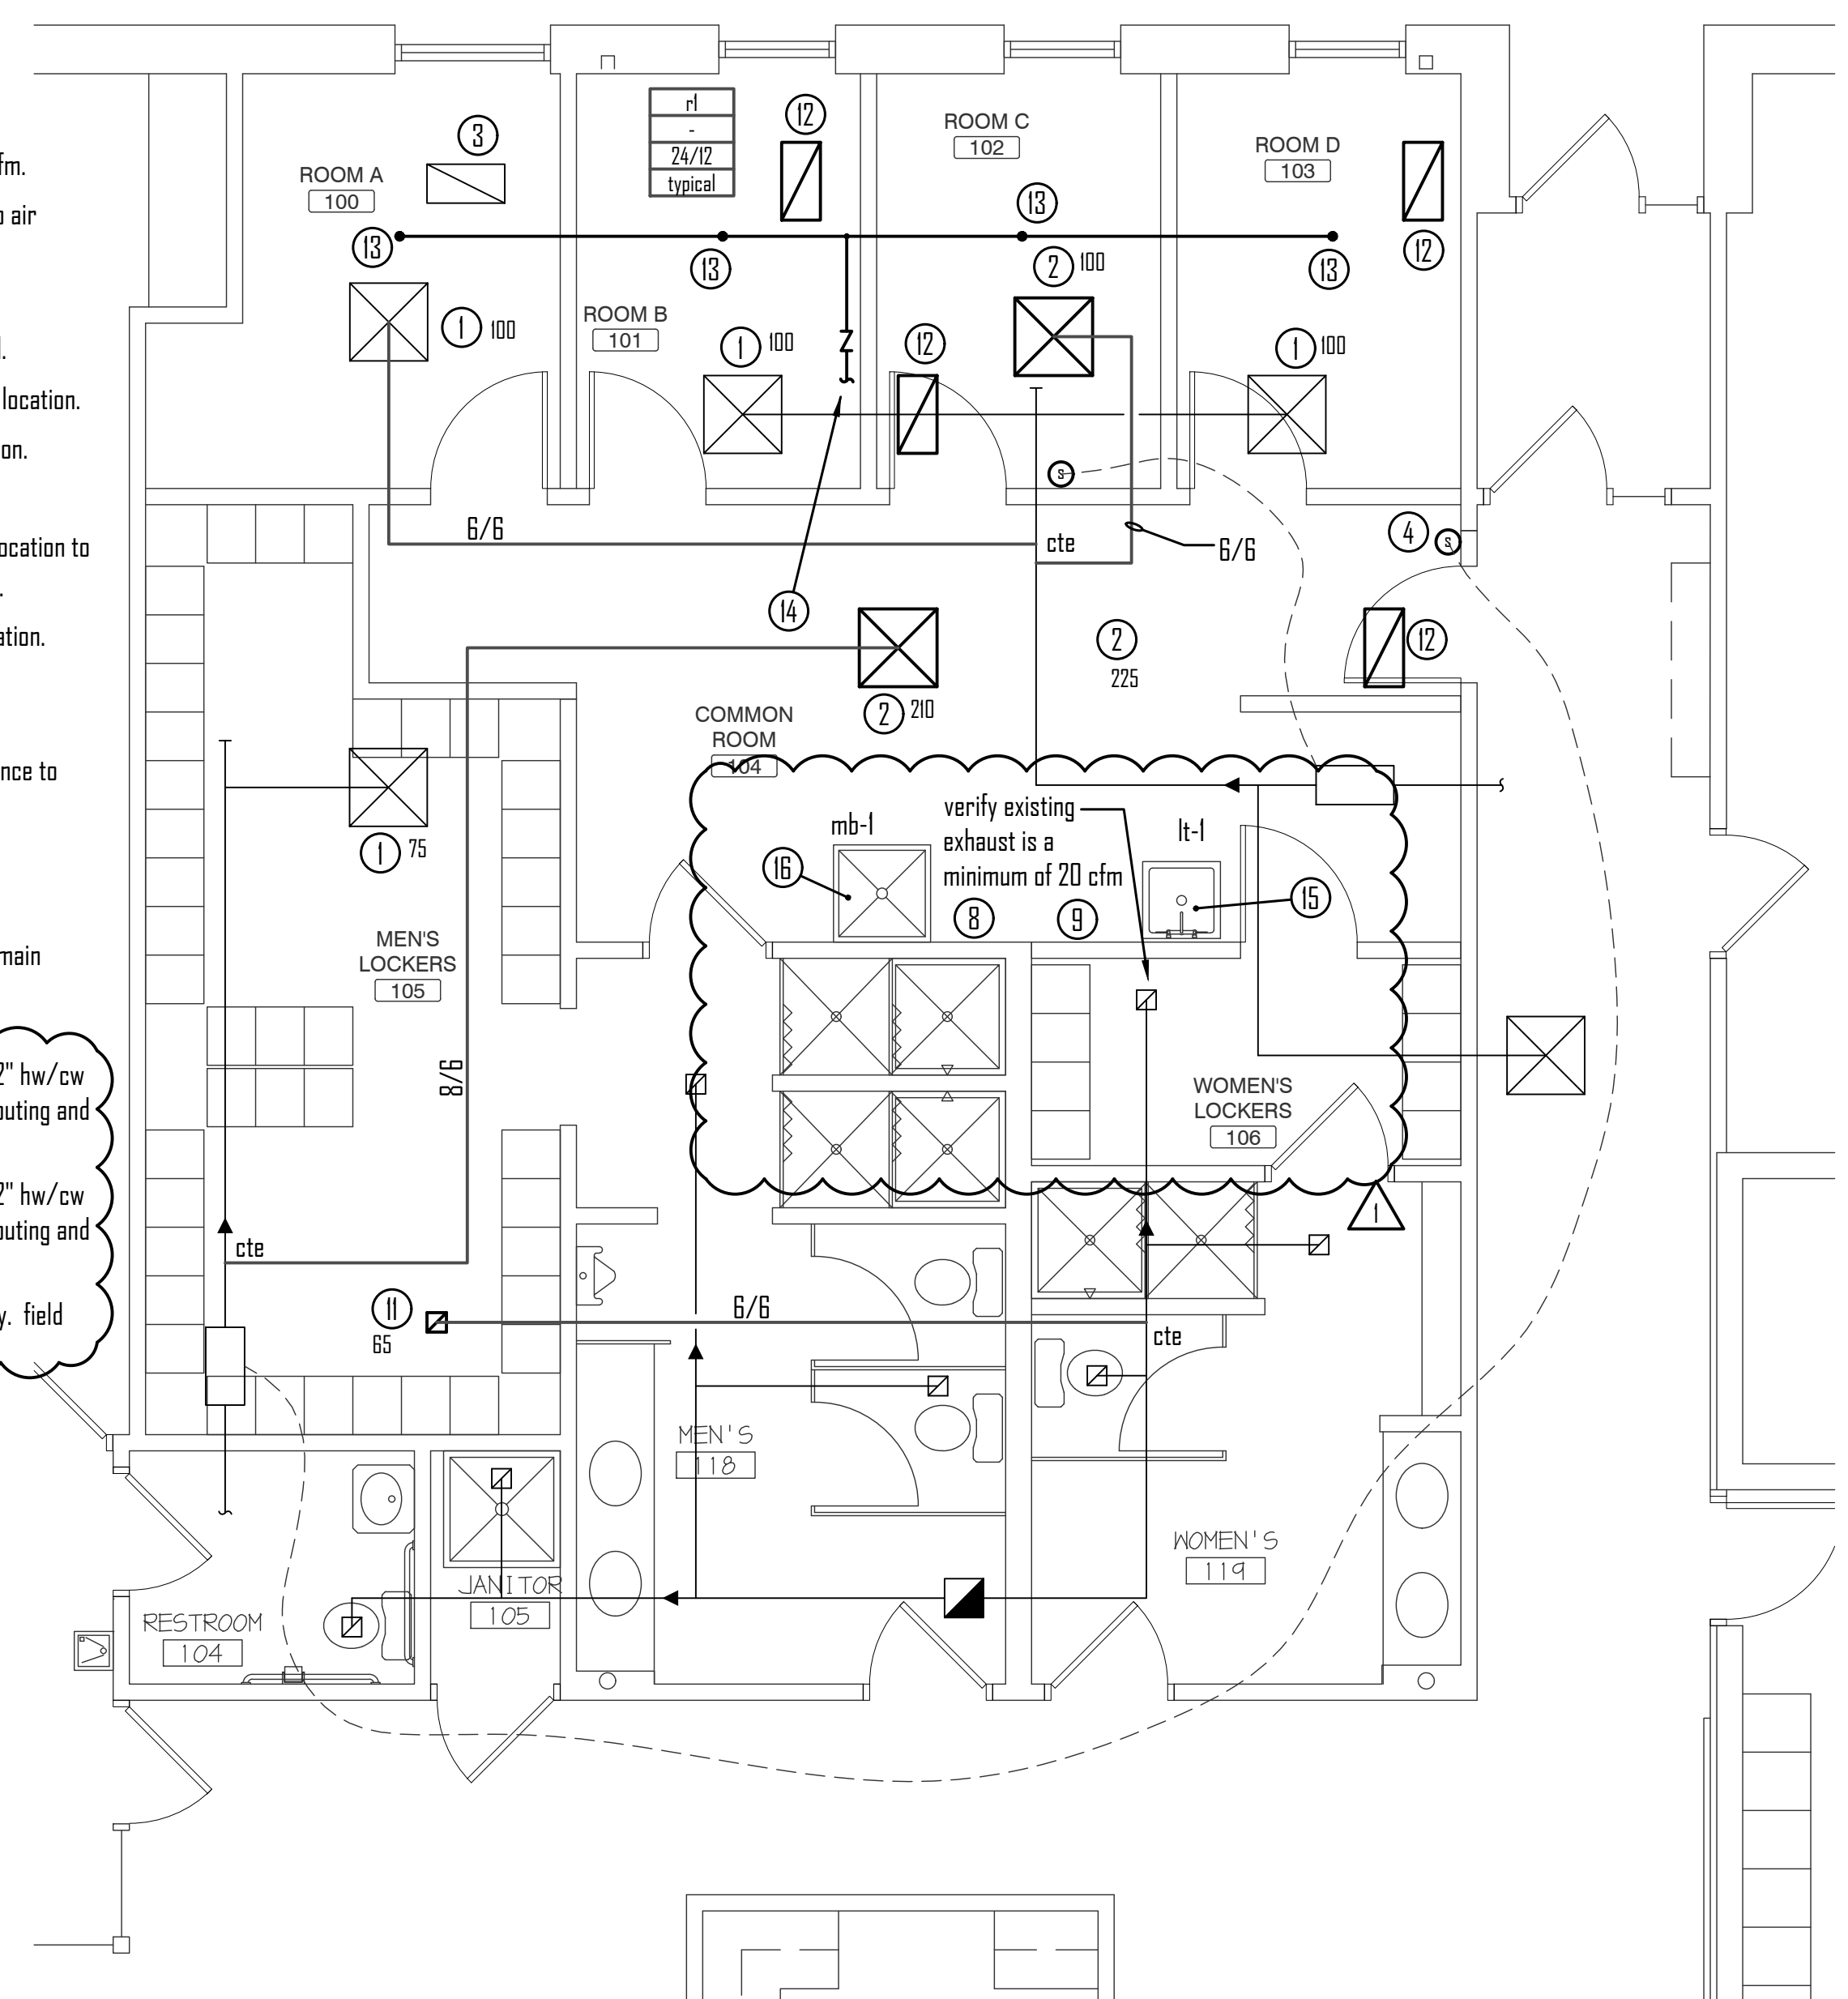

HVAC AND PLUMBING PLAN
scale: 1/4" = 1'-0"


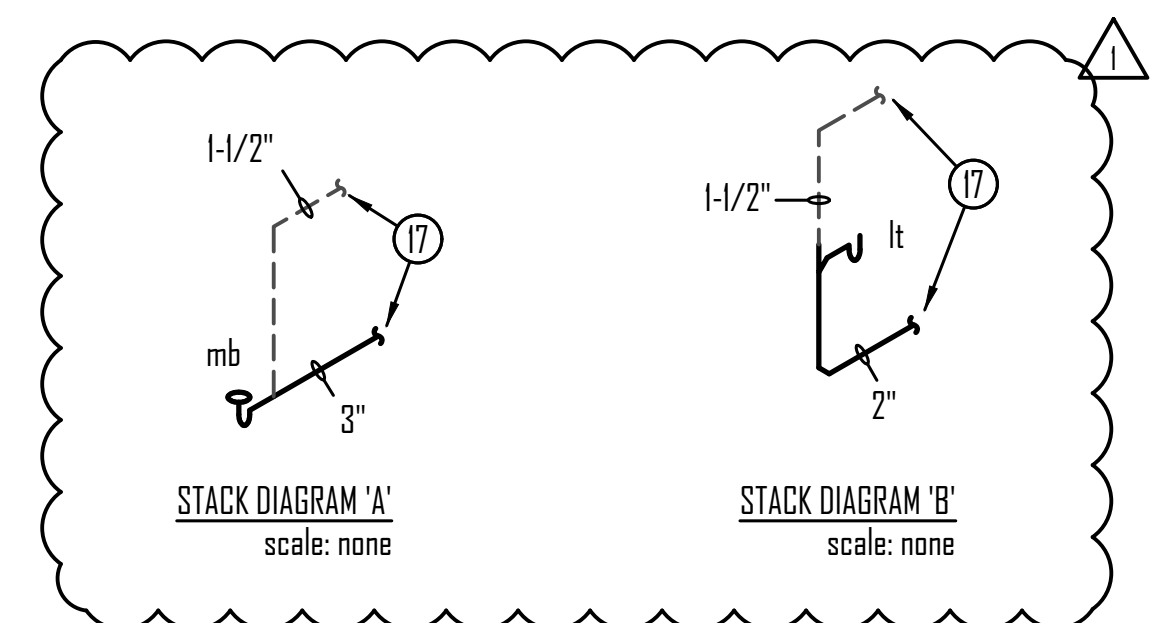


STACK DIAGRAM 'A'
scale: none

STACK DIAGRAM 'B'
scale: none

ELECTRICAL SPECIFICATIONS

- THE GENERAL CONDITIONS OF THE CONTRACT, THE SUPPLEMENTARY CONDITIONS AND ALL THE SECTIONS OF DIVISION 1, TOGETHER WITH THE FOLLOWING SPECIFICATIONS ARE A PART OF THE CONTRACT FOR THE WORK COVERED HEREIN. PROVIDE AS-BUILT DRAWINGS.
- GUARANTEE ALL MATERIAL AND LABOR FOR ONE YEAR FROM DATE OF PROJECT ACCEPTANCE BY OWNER. REPAIR ALL DEFECTIVE MATERIAL AT NO CHARGE DURING GUARANTEE PERIOD.
- THE ELECTRICAL CONTRACTOR SHALL VISIT THE SITE TO FAMILIARIZE HIMSELF WITH EXISTING CONDITIONS. NO ADDITIONAL COMPENSATION SHALL BE AWARDED WHERE EXTRA LABOR OR MATERIAL ARE REQUIRED BECAUSE OF UNFAMILIARITY.
- ELECTRICAL WORK SHALL BE INSTALLED IN ACCORDANCE WITH THE NATIONAL ELECTRICAL CODE, ALL APPLICABLE FEDERAL, STATE AND LOCAL CODES AND ORDINANCES. THE ELECTRICAL CONTRACTOR SHALL SECURE AND PAY FOR ALL PERMITS AND INSPECTIONS REQUIRED TO PERFORM THE ELECTRICAL WORK.
- THE DRAWINGS INDICATE DIAGRAMMATICALLY THE LOCATION OF ELECTRICAL DEVICES, EQUIPMENT AND FIXTURES, AND THE METHOD OF CONNECTION. THE DRAWINGS DO NOT INDICATE EVERY CONNECTION IN DETAIL OR ALL FITTINGS FOR A COMPLETE SYSTEM. MATERIAL OR LABOR WHICH IS NOT INDICATED ON THE DRAWINGS OR INCLUDED IN THE SPECIFICATIONS, BUT IS ABSOLUTELY NECESSARY TO COMPLETE THE WORK, SHALL BE PROVIDED.
- BRING CONFLICTS TO THE ATTENTION OF THE ARCHITECT FOR RESOLUTION BEFORE SIGNING THE CONTRACT OR PROCEEDING WITH THE WORK. FAILURE TO NOTIFY THE ARCHITECT IN WRITING WILL CAUSE THE ARCHITECT'S INTERPRETATION OF THE CONTRACT DOCUMENTS TO BE FINAL.
- THE ELECTRICAL CONTRACTOR SHALL REFER TO PLANS AND SPECIFICATIONS OF THE OTHER TRADES FOR ELECTRICAL WORK PERTAINING TO THE INSTALLATION OF OTHER TRADES. COORDINATE WITH THE GENERAL CONTRACTOR AND OTHER SUBCONTRACTORS TO RESOLVE INTERFERENCE'S WITHOUT ADDITIONAL COST TO THE OWNER.
- THE SCOPE OF WORK SHALL INCLUDE BUT NOT BE LIMITED TO:
 - A) BRANCH CIRCUIT PANEL BEARDS, FEEDERS, CONDUIT, BRANCH CIRCUITS, OUTLETS AND WIRING.
 - B) MOUNTING HANGWARE, CONDUIT & WIRING.
 - C) GROUNDING OF ALL SYSTEMS AND EQUIPMENT.
- ALL EQUIPMENT AND MATERIAL SHALL BE NEW AND BEAR UL LABELS AND LISTINGS. THE PHRASE "PROVIDED BY" WITHIN THE CONSTRUCTION DOCUMENTS SHALL EXPLICITLY REPRESENT "FURNISHED AND INSTALLED BY".
- SUBMIT SHOP DRAWINGS FOR ALL EQUIPMENT PRIOR TO ORDERING FOR THE PROJECT WITH CONTRACTOR REVIEW STAMP AND SIGNATURE.
- COORDINATE WORK WITH THE OTHER TRADES FOR SPACE REQUIREMENTS, DISCREPANCIES OR CONFLICT OF WORK. THE ELECTRICAL CONTRACTOR SHALL BE RESPONSIBLE FOR CUTTING AND PATCHING REQUIRED FOR THE INSTALLATION OF THE ELECTRICAL WORK. VERIFY EXACT LOCATIONS OF DEVICES WITH ARCHITECT PRIOR TO ROUGH-IN.
- CONDUIT SHALL BE E.M.T. WITH SET SCREW FITTINGS CONCEALED ABOVE GRADE, CONDUIT SUPPORTS, FASTENERS, ETC. SHALL BE GALVANIZED AND CORROSION RESISTANT. SUPPORT CONDUIT FROM BUILDING STRUCTURE ONLY. DO NOT USE CEILING HANGER WIRES OR ROOF DECK FOR SUPPORT. THE USE OF PERFORATED METAL STRAPS IS NOT PERMITTED ON THE PROJECT. INSTALL PULL WIRES IN EMPTY OR FUTURE USE CONDUITS. TYPE MC CABLE MAY BE USED FOR BRANCH CIRCUIT WIRING WHERE PERMITTED BY AUTHORITY HAVING JURISDICTION. HOWEVER, RUNS TO PANEL BOARDS SHALL BE E.M.T. ABSOLUTELY NO PVC SHALL BE PERMITTED ABOVE FLOOR LINE WITHIN BUILDINGS. TYPE NM CABLE IS NOT PERMITTED ON THE PROJECT. OUTLET BOXES IN DRY LOCATIONS SHALL BE GALVANIZED STEEL TYPE, 1-1/2" DEEP MINIMUM. SINGLE OR GANG STYLE OF SIZE TO ACCOMMODATE DEVICES NOTED. BOXES SHALL BE EQUIPPED WITH PLASTER RINGS AS NECESSARY.
- FIRE STOP ALL FIRE RATED WALL PENETRATIONS PER UL APPROVED METHOD, SUCH AS RTY FOAM (NON-DELETERIOUS), RACEWAY PASSING FROM THE INTERIOR TO THE EXTERIOR OF THE BUILDING SHALL BE FILLED WITH AN APPROVED MATERIAL TO PREVENT THE CIRCULATION OF WARM AIR TO A COLDER SECTION OF THE RACEWAY.
- WIRE SHALL HAVE SOLID OR STRANDED COPPER CONDUCTORS FOR #10 AND #12 WIRE AND STRANDED COPPER CONDUCTORS FOR WIRE #8 AND LARGER. WIRE SHALL HAVE GROUNDVOLT THIN/THWN INSULATION. MINIMUM SIZE WIRE SHALL BE #12 AWG. TAG ALL CONDUCTORS AT TERMINATIONS AT JUNCTION BOXES WITH BRADY LABELS. TORQUE TERMINATIONS PER MANUFACTURER'S RECOMMENDATIONS.
- PANEL DIRECTORIES SHALL BE TYPED. PROVIDE AND INSTALL ENGRAVED PHENOLIC NAME PLATES FOR MOTOR STARTERS, PANEL BOARDS, SAFETY SWITCHES, ETC.
- TEST WIRING SYSTEMS FOR SHORTS AND GROUNDINGS PRIOR TO ENERGIZING CIRCUITS.
- CONNECT ALL HVAC EQUIPMENT PER APPROVED MANUFACTURER'S DRAWINGS.
- GROUNDING OF EQUIPMENT AND DEVICES SHALL COMPLY WITH N.E.C. ARTICLE 250 AND AUTHORITY HAVING JURISDICTION. PROVIDE AND INSTALL A SEPARATE EQUIPMENT GROUNDING CONDUCTOR IN ALL CONDUITS.
- THE ELECTRICAL CONTRACTOR IS CAUTIONED THAT THE BUILDING IS OCCUPIED AND WORK SHALL NOT INTERFERE WITH THE NORMAL OPERATION OF THE BUILDING AND ITS TENANTS. THE PROJECT SHALL BE MANNED AT ALL TIMES BY A COMPETENT FOREMAN.
- ALL NEW OR MODIFIED EXPRESS EMERGENCY LIGHTING SHALL BE WIRED INTO LOCAL LIGHTING CIRCUIT, AHEAD OF ANY SWITCH OR CONTROL.
- FOR MEDICAL CARE FACILITIES (IF APPLICABLES) - ELECTRICAL CONTRACTOR SHALL COORDINATE "PATIENT CARE SPACES". BRANCH CIRCUITS IN THESE DESIGNATED AREAS SHALL BE WIRED PER THE STRICT REDUNDANT GROUNDING BRANCH CIRCUIT REQUIREMENTS PER NEC 517.2. THE RECEPTACLES ARE TO BE HOSPITAL GRADE. ALL RECEPTACLES IN OTHER AREAS (INCLUDING BUT NOT LIMITED TO, OFFICES, WAITING ROOMS, TOILET ROOMS, BREAK ROOMS AND CORRIDORS) SHALL BE TAMPER PROOF TYPE.

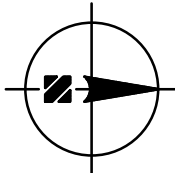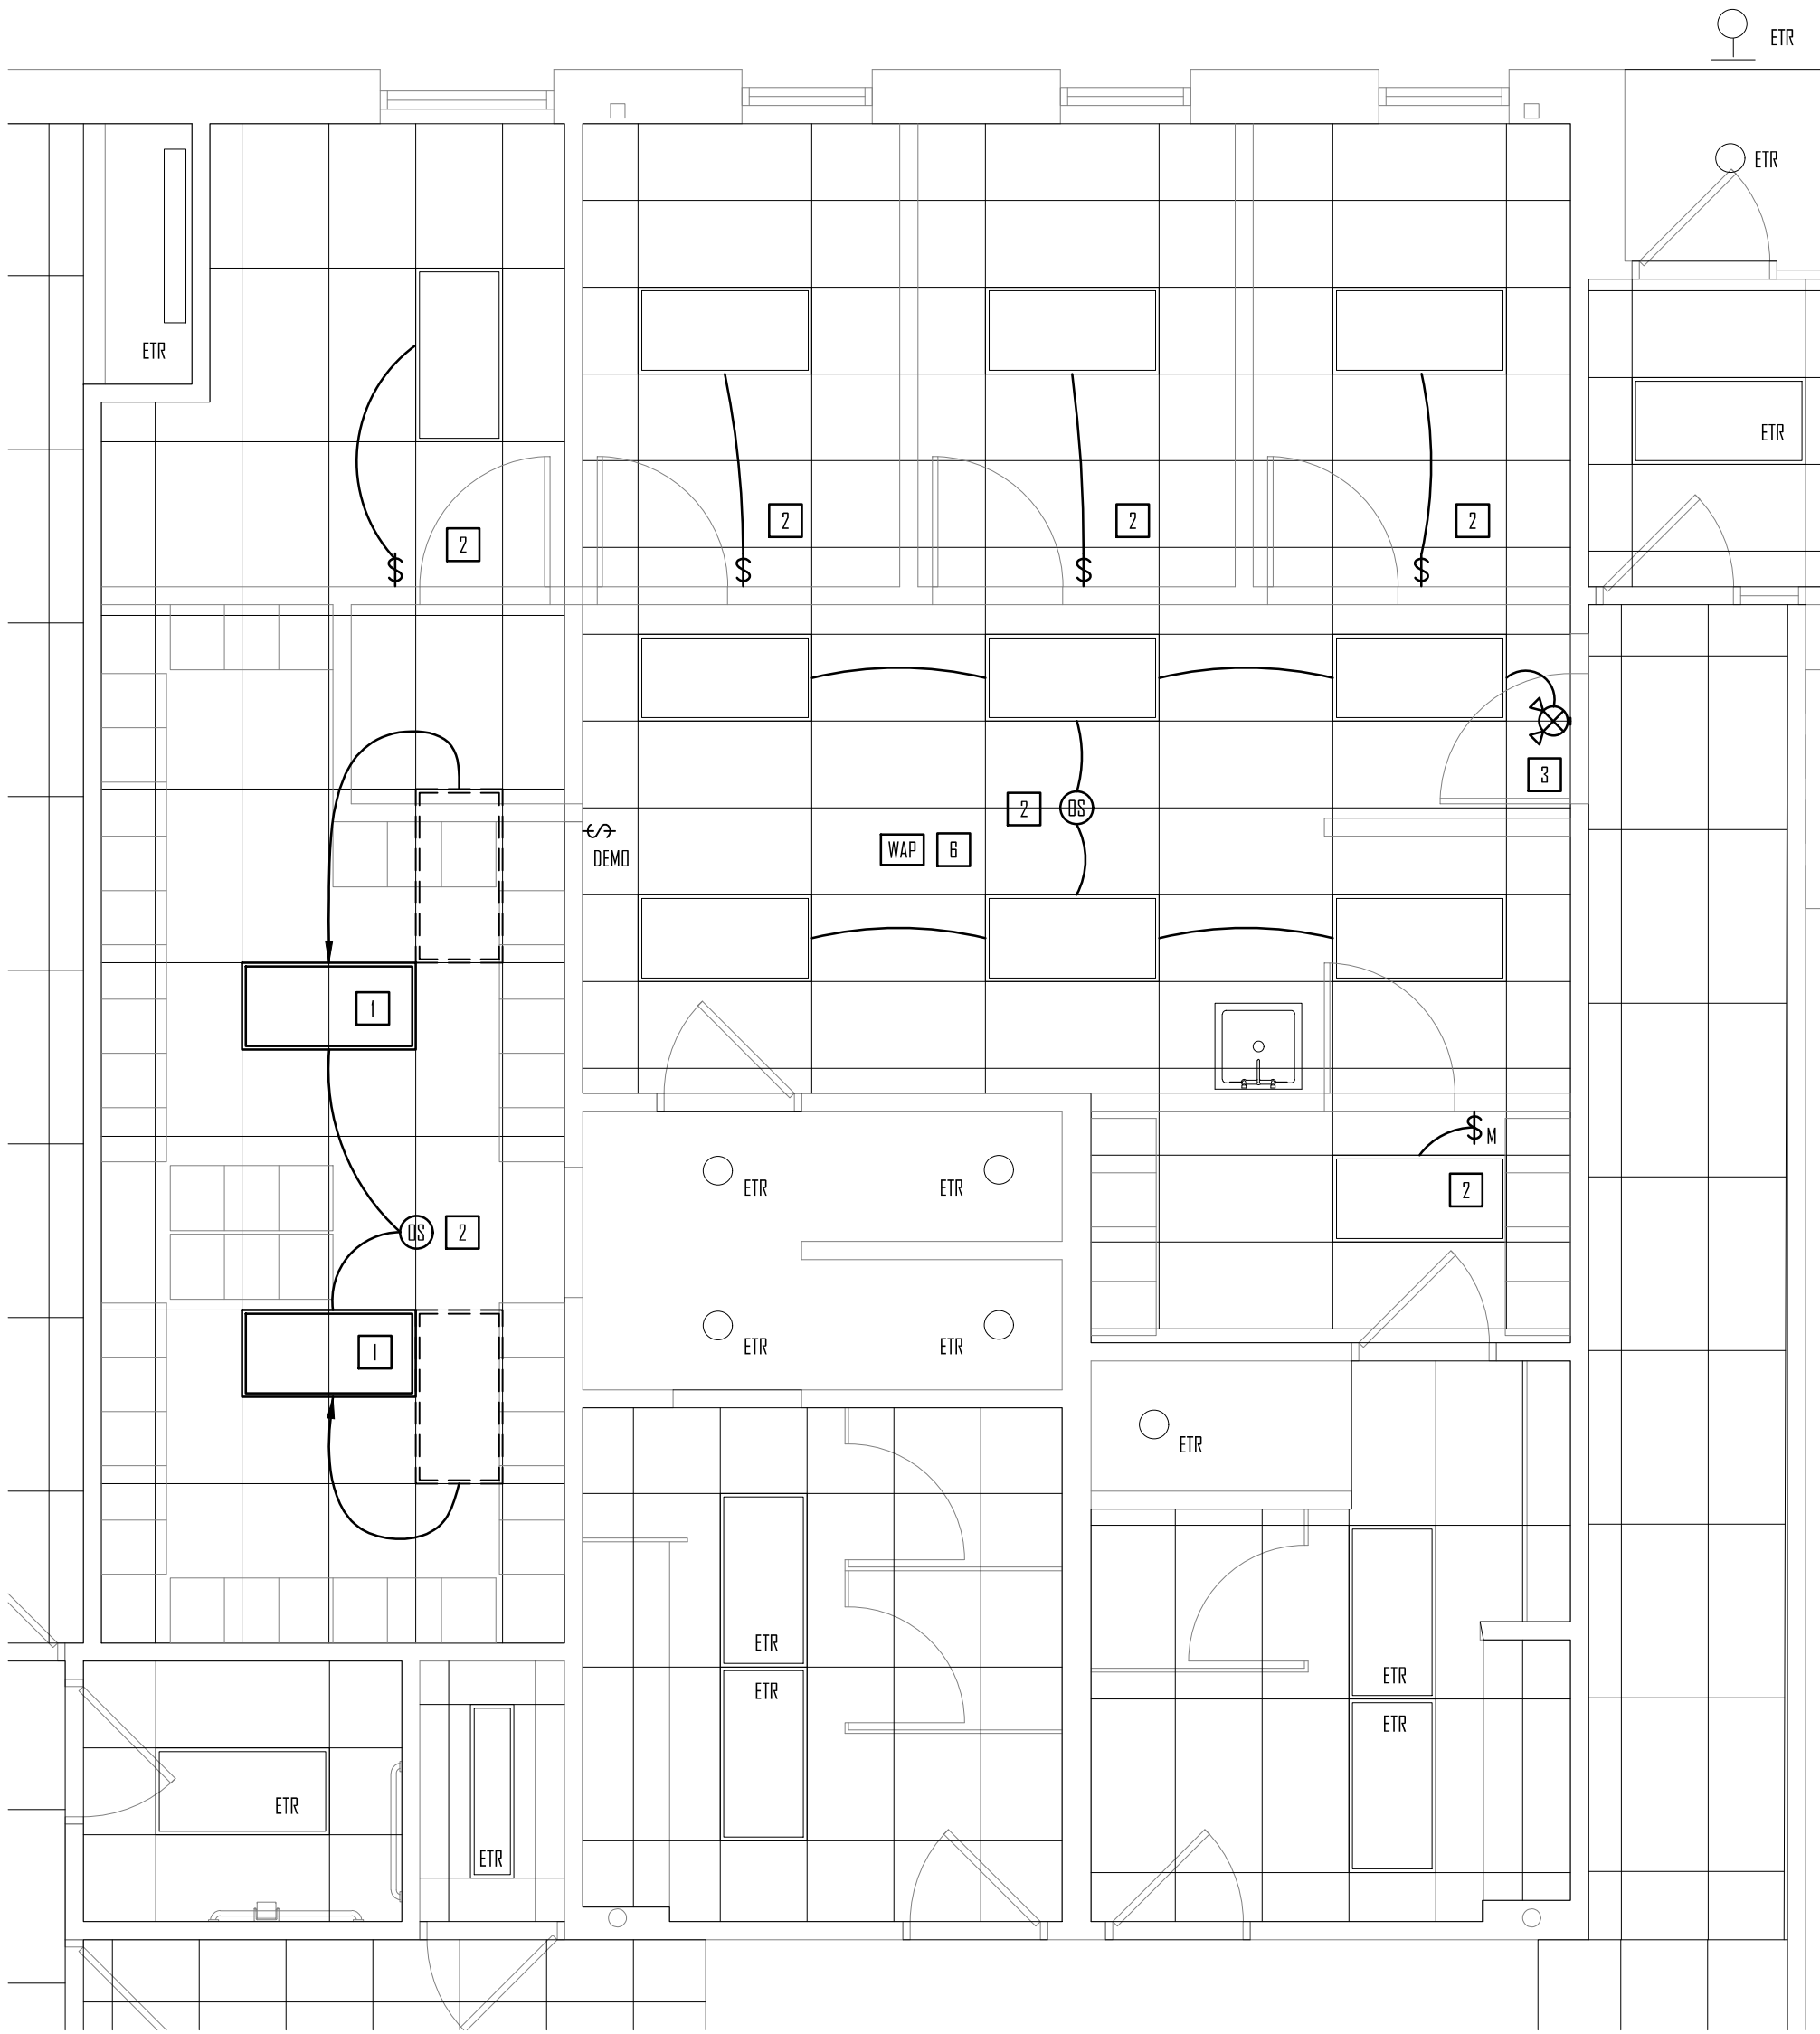



ELECTRICAL LIGHTING PLAN
scale: 1/4" = 1'-0"

ELECTRICAL ABBREVIATIONS

ACU	AIR CONDITIONING UNIT	G	GROUND
AF	AMP FUSE	HVAC	HEATING, VENTILATING, AIR CONDITIONING CONTRACTOR
AFF	ABOVE FINISHED FLOOR	MAU	MAKE-UP AIR UNIT
AFG	ABOVE FINISHED GRADE	MCA	MINIMUM CIRCUIT AMPERAGE
AHU	AIR HANDLING UNIT	MCB	MAIN CIRCUIT BREAKER
ATS	AUTOMATIC TRANSFER SWITCH	MLO	MAIN LUG ONLY
C	CONDUIT	MOD	MOTOR OPERATED DAMPER
CDU	CONDENSING UNIT	MOP	MAXIMUM OVERLOAD PROTECTION
CS	DISCONNECT SWITCH	NL	NIGHT LIGHT
DWH	DOMESTIC WATER HEATER	PC	PHOTOCELL
EBB	ELECTRIC BASE BOARD	RLA	RATED LEAD AMPS
E.C.	ELECTRICAL CONTRACTOR	RP	RECIRCULATION PUMP
EF	EXHAUST FAN	RTH	RADIANT TUBE HEATER
EH	ELECTRIC HEATER	RTU	ROOF TOP UNIT
ERV	ENERGY RECOVERY VENTILATOR	ST	SHUNT TRIP
ETR	EXISTING TO REMAIN	UG	UNDERGROUND
EWV	ELECTRIC WATER COOLER	UH	UNIT HEATER
EX	EXISTING	UND	UNLESS NOTED OTHERWISE
F	FURNACE	WP	WEATHER PROOF

ELECTRICAL SYMBOL LEGEND


- SQUARE JUNCTION BOX WITH FLOUSH COVER
- DUPLEX RECEPTACLE - VERIFY MOUNTING HEIGHT IN FIELD
- QUADRUPLUX RECEPTACLE - VERIFY MOUNTING HEIGHT IN FIELD
- DUPLEX RECEPTACLE - CEILING MOUNTED OR 6" ABOVE WINDOW
- COMBINATION DATA & VOICE - MOUNTED - 18" AFF (QND) WITH A MINIMUM 1 1/2" C (COORDINATE WITH LOW-VOLTAGE/DATA CONTRACTOR) FROM THE BOX TO ABOVE THE ACCESSIBLE CEILING WITH A PROTECTIVE BUSHING AT THE TERMINATION POINT. SECURE AND SUPPORT THE CONDUIT PER NEC REQUIREMENTS.
- SWITCH - SINGLE POLE
- M - MOTION SENSOR (WITH MANUAL OVERRIDE)
- D - DIMMER
- ELECTRICAL PANEL - SURFACE MOUNTED
- HOME RUN, PANEL AND CIRCUIT NUMBER, 2-#12, #12G, 3/4" C, TO A 20A-1P C/B TYPICALLY
- A-1 SAME AS ABOVE, HOME RUN AND WIRING OMITTED FOR CLARITY
- 3 WIRES, 1 NEUTRAL
- 4 WIRES, 1 NEUTRAL
- BELOW FLOOR CONDUIT
- "RUN CONTINUES" INDICATION
- WAP WIRELESS ACCESS POINT

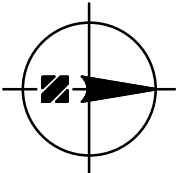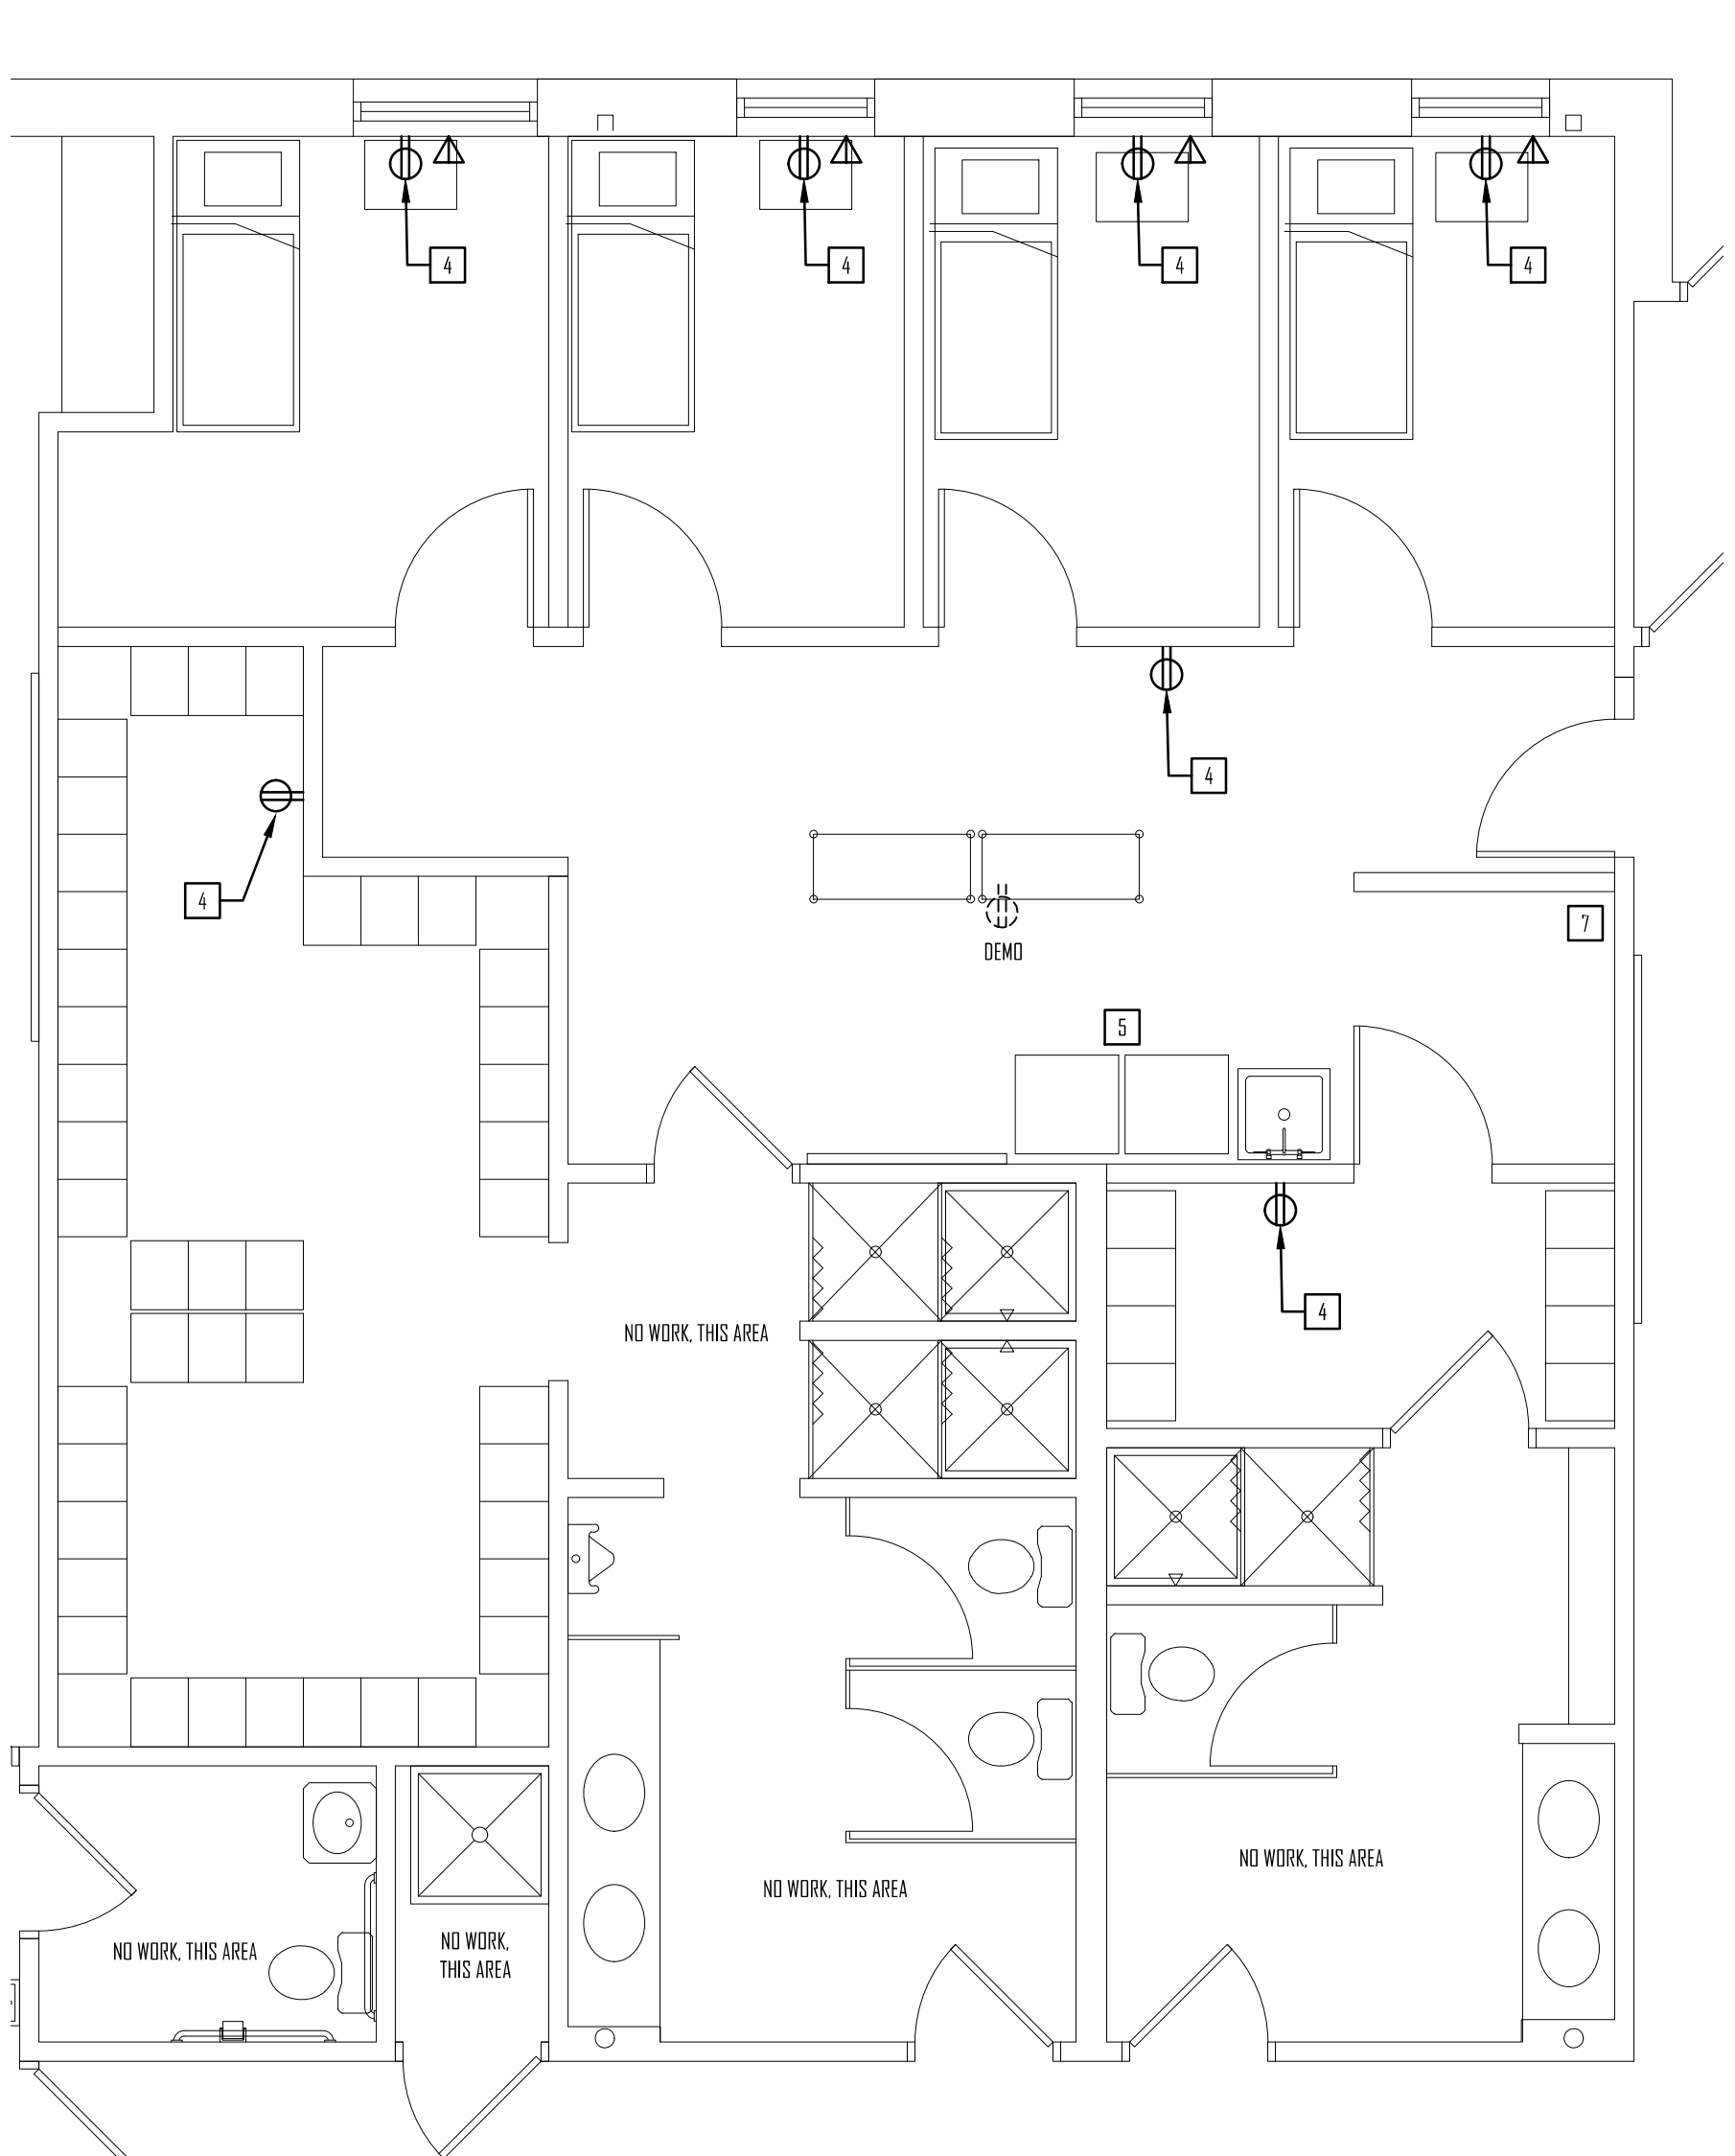

ELECTRICAL POWER PLAN
scale: 1/4" = 1'-0"

ELECTRICAL PLAN KEYED NOTES

- RELOCATE EXISTING LIGHT AS SHOWN. LIGHT(S) TO REMAIN ON EXISTING BRANCH CIRCUIT.
- E.C. TO REWIRE EXISTING/RELOCATED LIGHT(S) FOR NEW CONTROL(S) AS SHOWN. LIGHT(S) TO REMAIN ON EXISTING BRANCH CIRCUIT.
- NEW EMERGENCY LIGHT/EXIT SIGN COMBO. MATCH EXISTING. WIRE INTO LOCAL LIGHT CIRCUIT AHEAD OF ANY SWITCH OR CONTROL.
- RELOCATE EXISTING OUTLET AS SHOWN (MADE AVAILABLE VIA DEMOLITION), E.C. TO INTERCEPT EXISTING CIRCUIT ABOVE CEILING AND EXTEND CABLE AND CONDUIT AS REQUIRED TO NEW LOCATION. COORDINATE AND VERIFY IN FIELD. IF NO OUTLET IS AVAILABLE FOR RELOCATION, E.C. SHALL PROVIDE NEW AS SHOWN AND WIRE INTO EXISTING LOCAL RECEPTACLE CIRCUIT (VERIFY CIRCUIT CAPACITY) OR WIRE NEW 2 - #12, #12 G, 3/4" C, TO A NEW (OR EXISTING SPARE) 20A-1P C/B IN EXISTING LEGAL ELECTRICAL PANEL. COORDINATE MOUNTING AND BOX TYPE IN FIELD. A SHALLOW BOX MAY NEED TO BE USED ON EXISTING MASONRY WALLS.
- RELOCATED WASHER AND DRYER, E.C. SHALL INTERCEPT EXISTING CIRCUITS ABOVE CEILING AND EXTEND CONDUIT AND CONDUCTORS AS REQUIRED TO NEW LOCATION SHOWN, E.C. SHALL PROVIDE OUTLETS TO MATCH THE EXISTING INSTALLATION CONDITIONS PRIOR TO DEMOLITION.
- EXISTING WIFI EXTENDER IN CEILING TO REMAIN.
- REMOVE/RELOCATE EXISTING PHONE CONNECTION, THERMOSTAT AND POWER RECEPTACLE. COORDINATE LOW VOLTAGE WITH CONTRACTOR IN FIELD AND MECHANICAL DRAWINGS. VERIFY NEW LOCATIONS IN FIELD WITH OWNER.

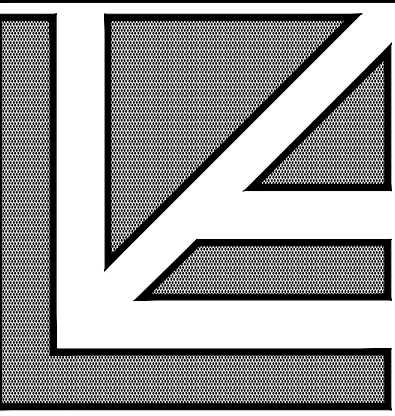

LARSEN
ARCHITECTS

12815 DETROIT AVE,
LAKEWOOD, OHIO 44107
216-221-2350

PROJECT No: 25118

FIRE DEPTARTMENT
RUSSELL TOWNSHIP FIRE DEPT.
14810 CHILICOTHE RD.
NOVELTY, OH 44072

DRAWN BY: EE
CHECKED BY: EE

ISSUE
Issued for
Permit: 2025.08.29

THE CONTRACTOR AGREES THAT LARSEN ARCHITECTS SHALL BE THE FINAL DETERMINER OF THE SCOPE & INTENT OF THESE DRAWINGS.

THE CONTRACTOR SHALL VERIFY ALL CONDITIONS AND DIMENSIONS AT THE JOB SITE AND NOTIFY THE ARCHITECTS OF ANY DISCREPANCIES OR OMISSIONS BEFORE BEGINNING OR FABRICATING ANY WORK.

NO SUBSTITUTIONS ARE PERMITTED UNLESS APPROVED BY THE ARCHITECT PRIOR TO BID ACCEPTANCE.

ANY WORK PERFORMED IN CONFLICT WITH THE CONTRACT DOCUMENTS OR ANY CODE REQUIREMENTS SHALL BE CORRECTED BY THE CONTRACTOR AT HIS OWN EXPENSE.

NOTES & DETAILS ON DRAWINGS SHALL TAKE PRECEDENCE OVER GENERAL NOTES AND TYPICAL DETAILS.

ANY DUPLICATION OR MODIFICATION IS FORBIDDEN WITHOUT PRIOR WRITTEN PERMISSION FROM LARSEN ARCHITECTS.

SHEET NUMBER

E1.1
ELECTRICAL PLANS